

KANSAS

Kearny

Section 23 Township 26 Range 37W

Well No. 1 Tate


Company Northern Natural Gas

Hugoton

NORTH

WEST

EAST

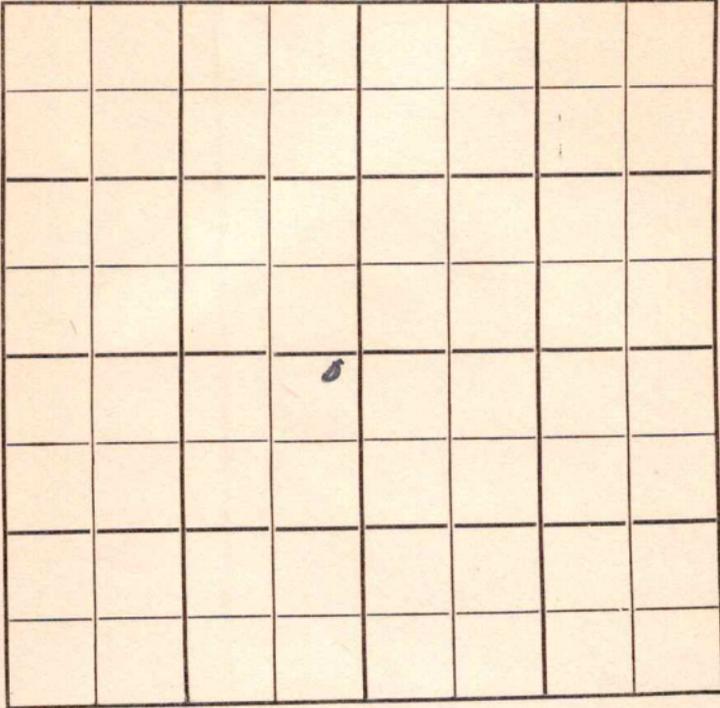

SOUTH

Kearny

Sec. 23 Twp. 26 R. 37W

Well No. #1 Tate Farm _____

Northern Natural Gas

Company

Hugoton Pool


100' Ft. from N. Line

_____ Ft. from S. Line

100' Ft. from E. Line

_____ Ft. from W. Line

NE SW

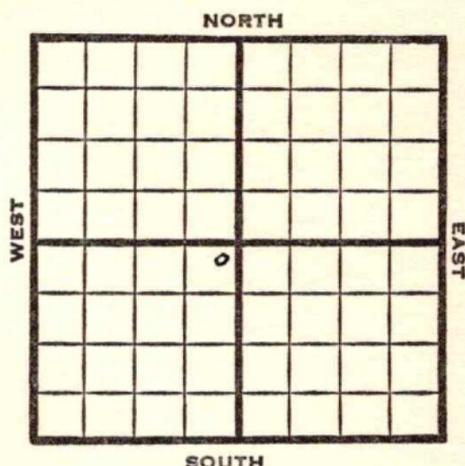

1949

Elev 3113'

REPORT

9/21

RUR

9/28

10" @ 455'

TD 2450'

7" @ 2440'

10/5

"

10/12

Drlg 2608'

10/19

TD 2724'

296' of 5" Perf Liner @ 2724'

21000 acid

10/26

"

11/2

TD 2724'

7" @ 2440'

296' of 5" Perf Liner @ 2724'

21000 acid

16,163,000 Gas

409# R Pr.

Comp

COMPLETED

Map No. _____ Sec. 23 Twp. 26 R. 37W

Well No. 1 Tate

Northern Natural Gas Company

Contractor

NE SW

FIRST REPORT
SECTION PLAT

100 Ft. from N. Line

_____ Ft. from S. Line

100 Ft. from E. Line

_____ Ft. from W. Line

		o	

Kearny County

RECORD

Location _____

Cased _____ in., _____ ft.

Rig up _____

Sand _____

Drilling and Remarks:

Gas _____

R U R

Oil _____

Total Depth _____

PRODUCTION

1st 24 hrs. Nat. _____

1st 24 hrs. after shot _____

Gas _____ Cu. Ft.

Dry Hole _____

Abandoned _____

Date

SEP 21 1949 19

S. J. LEWIS Scout

Kansas

Hugoton Pool

Map No. _____ Sec. 23 Twp. 26 R. 37WWell No. 1 Tate

Northern Natural Gas Company

COMPLETE

Contractor


NE SW

E. 3/18
SECTION PLAT100 Ft. from N. Line

_____ Ft. from S. Line

100 Ft. from E. Line

_____ Ft. from W. Line

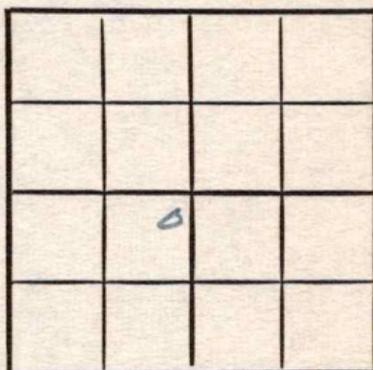

Kearny County

Location _____

Rig up _____

Drilling and Remarks:

7" C2448
296' of 5" Prof. Inst.
C2724
21000 acid
16,163,000 cu

RECORD

Cased _____ in., _____ ft.

Sand _____

Gas _____

Oil _____

Total Depth 2724

PRODUCTION

1st 24 hrs. Nat. _____

1st 24 hrs. after shot _____

Gas _____ Cu. Ft.

Dry Hole _____

Abandoned _____

Date

NOV 2 1949

19

S. J. LEWIS Scout