


Section 25 Township 26 Range 37-W

Well No. #4 Broadhurst

Company Northern Natural

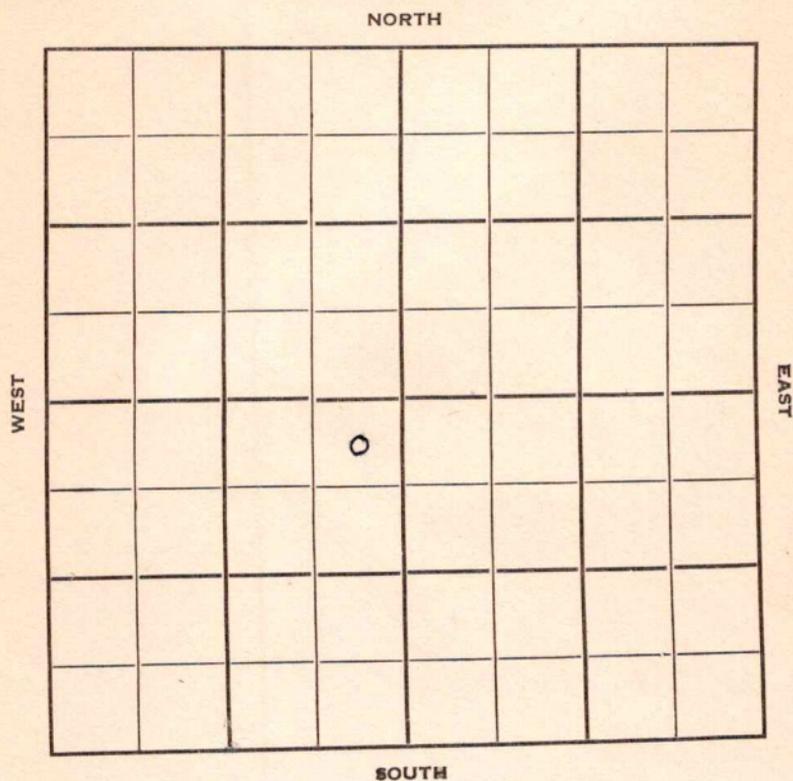

Kearny

Sec. 25 Twp. 26 R. KANSAS 37W

Well No. #4 Broadhurst Farm

Northern Natural Company

Wyatt Contractor

Hugoton


200' Ft. from N. Line

_____ Ft. from S. Line

200' Ft. from E. Line

_____ Ft. from W. Line

NE SW

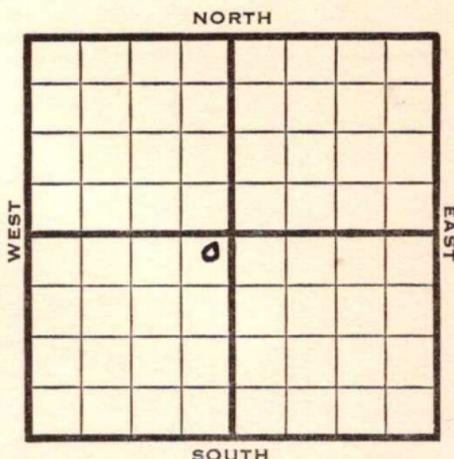

1950

Elev 3109

REPORT

8/16

Location

10/18

Spud 8-16-50

10" @ 470

7" @ 2445

TD 2455

Her 2440

Krider 2494

Win 2535

Towanda 2590

Ft. Riley 2625

Comp 18,635,000 gas open flow

Completed

COMPLETED

