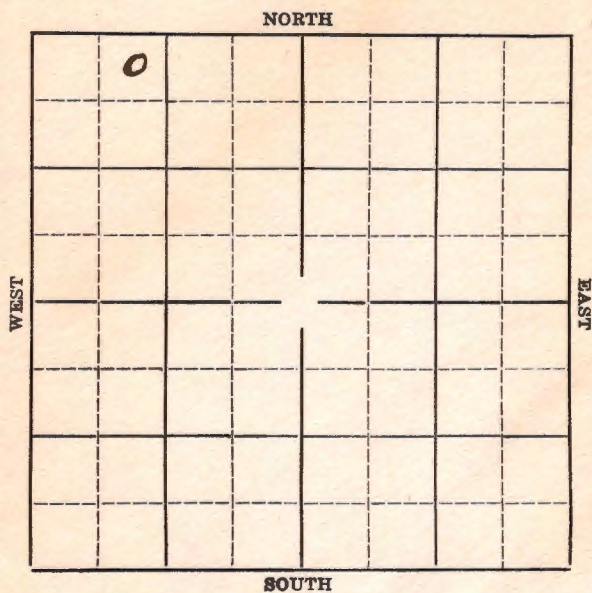


Section 16 Township 26 Range 4-WWell Number #3-HilgerCompany Stanolind et al

KANSASMap No. 40 Sec. 16 Twp. 26 R. 4WWell No. 3 HilgerStandard Oil Co. Company

Contractor

SECTION PLAT

<u>0</u>			

330 Ft. from N. Line

_____ Ft. from S. Line

_____ Ft. from E. Line

990 Ft. from W. Line**COMPLETED**

Location _____

Rig up _____

Drilling and Remarks:

Verla 4035.Port 1227 Nat.**RECORD**

Cased _____ in., _____

Sand _____

Gas _____

Oil _____

Total Depth 4040**PRODUCTION**

1st 24 hrs. Nat. _____

1st 24 hrs. after shot _____

Gas _____

Dry Hole _____

Abandoned _____

Date

OCT 7 1936 19S. J. LEW

Map No. 40 Sec. 16 Twp. 24 R. 4W **KANSAS**

Well No. 3 Helger

Standard Oil Company

Contractor

SECTION PLAT.

0			

220 Ft. from N. Line

_____ Ft. from S. Line

_____ Ft. from E. Line

990 Ft. from W. Line

FIRST REPORT

Location ✓

Rig up _____

Drilling and Remarks:

RECORD

Cased _____ in., _____ ft.

Sand _____

Gas _____

Oil _____

Total Depth _____

PRODUCTION

1st 24 hrs. Nat. _____

1st 24 hrs. after shot _____

Gas _____ Cu: Ft.

Dry Hole _____

Abandoned _____

Date

JUL 22 1936 19

S. J. LEWIS

Scout

KANSAS

Map No. 40 Sec. 16 Twp. 26 R. 4WWell No. 3 HilgerStandard Oil Co. Company

Contractor

SECTION PLAT

0			

920 Ft. from N. Line

_____ Ft. from S. Line

_____ Ft. from E. Line

990 Ft. from W. Line

FIRST REPORTS

CORRECTION ~~SEE PAGE 426~~Location ✓

Rig up _____

Drilling and Remarks:

RECORD

Cased _____ in., _____ ft.

Sand _____

Gas _____

Oil _____

Total Depth _____

PRODUCTION

1st 24 hrs. Nat. _____

1st 24 hrs. after shot _____

Gas _____ Cu. Ft.

Dry Hole _____

Abandoned _____

Date

JUL 29 1936

S. J. LEWIS

Scout