

O. W. D. D.

Reno


FORM 51 5M PETROL

KANSAS

Section 16 Township 26 Range 4W

Well No. #1 P. Hilger

Company ~~Magnolia~~ Hoodman & Jannetti

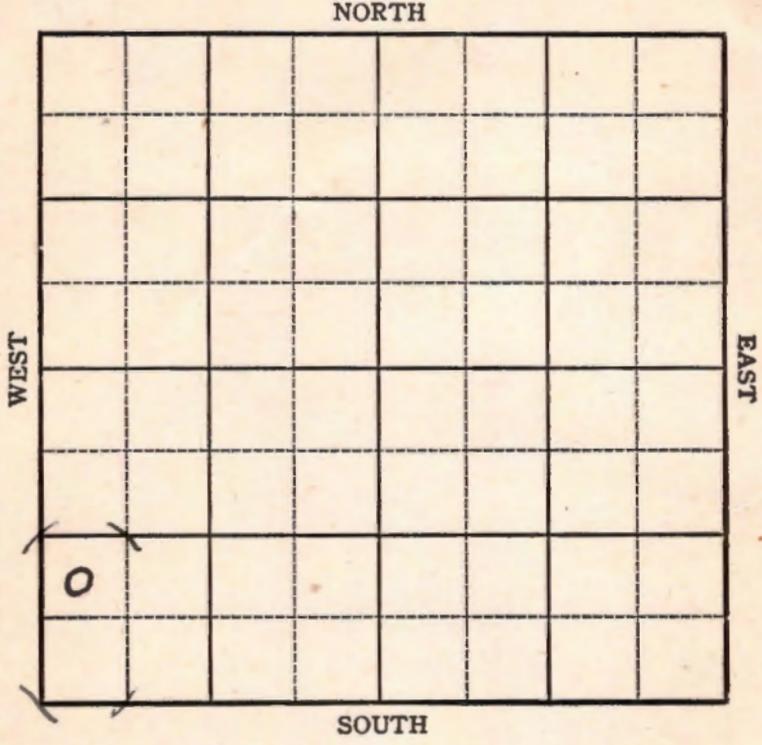

KANSAS

Reno

Sec. 16 Twp. 26 R. 4W

Well No. #1 P. Hilger Farm

Magnolia Company

Hilger


_____ Ft. from N. Line

990 Ft. from S. Line

_____ Ft. from E. Line

330 Ft. from W. Line

elev. 1474

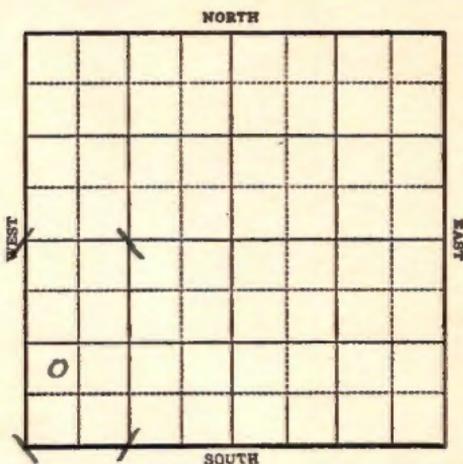

1944

R E P O R T

- 2/23 10" @ 196
WOC
- 3/1 Drlg. 2425
- 3/8 Drlg. 2750
- 3/16 Drilling 2850
- 3/22 **Lans 2852**
Miss 3612
Drlg. 3777
- 3/29 **Misener 4002**
Viola 4048
Simp. 4058
Arb. 4061
TD 4066
No Shows

ABANDONED

**GEOLOGICAL DEPT. HAS VELOCITY SURVEY
ON THIS WELL.**

County Reno Elev. 1474
 Sec. 16 Twp. 26 Rge. 46
 Company Woodman & Iannetti
 Farm Name Peter Hilger No. 1

TOPS	DEPTH	LOG	DATUM	Loc. in Sec.
Anh.				NW SW SW
TP.				
H.				
Tr.				
Dg.				Geol.
Bl.				
L.		2852		Contr.
K.C.				
B.K.C.				Pool
Ce.				
C.		3612		Hilger
M.		4032		
M.				ABANDONED
K.				
Mz.				OCT 24 56
Me.				
V.		4048		
S.		4058		
S.				
A.		4161		
R.				
PE.				
G.				
TD.	4178	4166		

Date Comm.

Old Info. old oper was Mag. Pet. 16"
 @ 196, D & A, New Information MIRT
 CO & DD 4178, Frip to DST

6124 56 DST 51 Pkr 4000-20

or 2 hrs see 45' WM BHP
 865/45" (2 cr's 4006-21 see
 sd no show)

DEA

Map No. **KANSAS** 40 Sec. **16** Twp. **26** R. **4W**

Well No. **1 P. Hilger**

Magnolia Company

FIRST REPORT Contractor

NW SW SW


SECTION PLAT

_____ Ft. from N. Line

990 Ft. from S. Line

_____ Ft. from E. Line

330 Ft. from W. Line

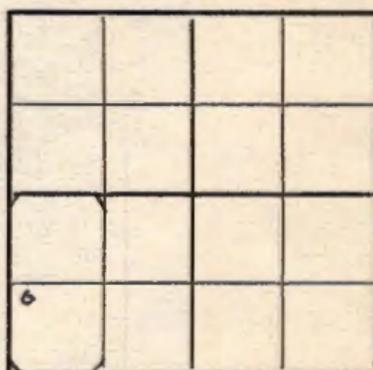

Hilger Pool

Location _____

Rig up _____

Drilling and Remarks:

10" - 196 WOC

RECORD

Cased _____ in., _____ ft.

Sand _____

Gas _____

Oil _____

Total Depth _____

PRODUCTION

1st 24 hrs. Nat. _____

1st 24 hrs. after shot _____

Gas _____ Cu. Ft.

Dry Hole _____

Abandoned _____

Date

FEB 23 1944 19

S. J. LEWIS Scout

KANSAS
 Map No. 40 Sec. 16 Twp. 26 R. 4W

Well No. 1 P. Hilger

Magnolia Company

ABANDONED Contractor

NW SW SW

SECTION PLAT

_____ Ft. from N. Line

990 Ft. from S. Line

_____ Ft. from E. Line

330 Ft. from W. Line

Hilger Pool

Location _____

Rig up _____

Drilling and Remarks:

Muzner 4002
Vida 4048
Simple 4058
Er 4061
No show

RECORD

Cased _____ in., _____ ft.

Sand _____

Gas _____

Oil _____

Total Depth 4066

PRODUCTION

1st 24 hrs. Nat. _____

1st 24 hrs. after shot _____

Gas _____ Cu. Ft.

Dry Hole _____

Abandoned _____

Date

MAR 29 1944

19

S. J. LEWIS Scout

