


Reno

Form 252-A
5M 4-32 MPC

Map No. **KANSAS** Sec. 16 Twp 26 R. 4^w

Well No. 1 Haltye "C" Farm _____
Stanford Amecada Company

330 Ft. from N. Line
_____ Ft. from S. Line
330 Ft. from E. Line
_____ Ft. from W. Line

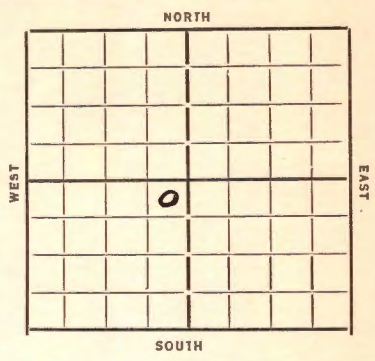

Date

REPORT

7/24	
5/23	Location
5/31	Rig
6/7	—
6/14	dyg 1790
6/21	" 2880 Lansing 2830
6/28	" 3540
7/5	" 3855 TC 3635 4059
7/12	M.L. 3923 TV 4057 TD 4069 hest
7/19	TD Corrected 4059 3800' oil 5 hrs.
7/26	No test
8/2	—
8/8	Visla 4056 TD 4058 429 Bbls oil Free water

COMPLETED

KANSAS

Map No. 40 Sec. 16 Twp. 26 R. 4W

Well No. L-Holtyre 'C'

Standard American Company

Contractor

FIRST REPORTS

SECTION PLAT

	0		

330 Ft. from N. Line

_____ Ft. from S. Line

330 Ft. from E. Line

_____ Ft. from W. Line

Location ✓

Rig up _____

Drilling and Remarks:

RECORD

Cased _____ in., _____ ft.

Sand _____

Gas _____

Oil _____

Total Depth _____

PRODUCTION

1st 24 hrs. Nat. _____

1st 24 hrs. after shot _____

Gas _____ Cu. Ft.

Dry Hole _____

Abandoned _____

Date

5-23-37 19

ORVAL MANNSCHRECK

Scout

Map No. 40 Sec. 16 Twp. 26 R. 4th

Well No. 1-Holtz (C)

Stanolind-Amerada Company

Contractor

COMPLETED

SECTION PLAT

	0		

330 Ft. from N. Line

_____ Ft. from S. Line

330 Ft. from E. Line

_____ Ft. from W. Line

Location _____

Rig up _____

Drilling and Remarks:

429 bbls oil.
Trace water

RECORD

Cased _____ in., _____ ft.

Sand 4056

Gas _____

Oil _____

Total Depth 4058

PRODUCTION

1st 24 hrs. Nat. _____

1st 24 hrs. after shot _____

Gas _____ Cu. Ft.

Dry Hole _____

Abandoned _____

Date

8-8-37

19

ORVAL MANNSCHRECK

Scout