
DX 78-1

KANSAS

Section 20 Township 26 Range 4W

Well No. #1 C. Geubell ~~"C"~~

Company Fleming & Woodman

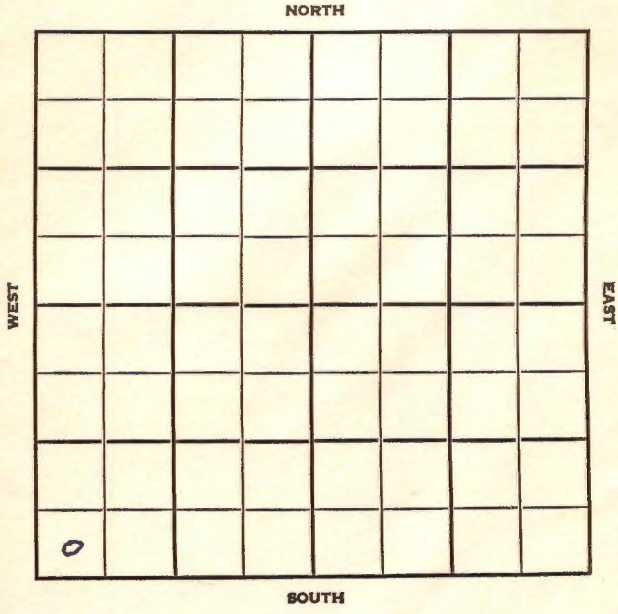

Reno KANSAS

SEC.	TWP.	R.
20	26	4W

WELL NO. #1 C.-
Geubelle "C"
FARM

COMPANY
Fleming & Woodman

CONTRACTOR
Co. Tools

SW Hilgers Pool


_____ Ft. from N. Line

330 Ft. from S. Line

_____ Ft. from E. Line

330 Ft. from W. Line

SW SW SW

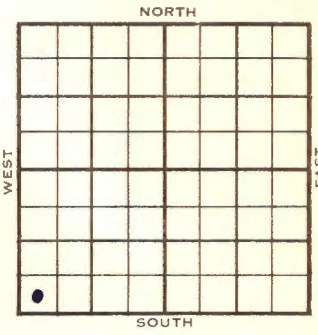

1955	ELEVATION 1441 REPORT
4/13	Spud 4-12-55 8" @ 252', WOC
6/8	Comm 4-12-55 BL 2794, L 2837, M 3587, K 3890, Mz 3968, V 4017, S 4030, TD 4040 8" @ 252/150, DST 3233-85, open 1 hr Rec 840' gip 40' clean oil 270' so & gcmw 1290/20 DST 3588-3623 open 1 hr Rec 600' gcm 500 mcfg 120' sw 1350/12" DST 3954-87 open 1 hr 3300' gip Rec 40' so & gcm 60' hocm 200' clean oil 100' wtr 1540/20" 5 1/2" @ 4039/175 CO to 4025 16/4017-20 FU 1500' oil 13 hr S/3 boph 4 hr Comp 23 bopd COMPLETED

DX-78

FORM 275 FOR SALE BY KANSAS BLUE PRINT CO.

County Reno State Kansas

Sec. 20 (Blk. Twp.) 26 (Sur. Rge.) 4W Map No.

Operator Fleming & Woodman

Well No. 1 Farm Geubelle "C"

Elev. Location SW SW SW



330 Ft. From S Line SW

330 Ft. From W Line Quarter

1st. Report APR 1 3 1955

Completion

Remarks Co. tools

Spudding Date 4-12-55

SW Hilgers Pool

Drlg. Data

8" @ 252 WOC

FABEN GILSTRAP

SCOUT TICKET DX-201 Kansas

SEC.	TWP.	R.
20	26	4W

WELL NO. 1 C. Geubelle FARM

COMPANY Fleming & Woodman

CONTRACTOR

CORRECTION


SW SW SW

_____ FT. FROM N. LINE

330 FT. FROM S. LINE

_____ FT. FORM E. LINE

330 FT. FROM W. LINE

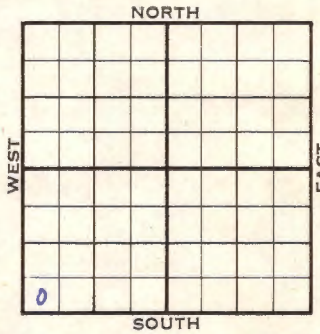

Reno County

☐ LOCATION

☐ RIG UP

DRILLING AND REMARKS:

Reported
Geubelle "C"

RECORD

CASED IN., FT.
SAND
GAS
OIL
TOTAL DEPTH

PRODUCTION

1ST 24 HRS. NAT.
1ST 24 HRS. AFTER SHOT
GAS CU. FT.
DRY HOLE
ABANDONED

DATE APR 2 0 1955

SCOUT FABEN GILSTRAP

FORM 513 REV. SUNRAY

County Reno Elev. 1441

Sec. 20 Twp. 26 Rge. 4W

Company Fleming & Woodman

Farm Name C. Geubelle No. 1

TOPS	DEPTH	LOG	DATUM
Anh.			
Tp.			
H.			
Tr.			
Dg.			
Bl.	2794		1353
L.	2837		1396
K.C.			
B.K.C.			
Ce.			
C.			
M.	3587		2146
M.			
K.	3890		2449
Mz.	3968		2527
Mq.			
V.	4017		2576
S.	4030		2589
S.			
A			
R.			
P€.			
G.			
T.D.	4040		

Loc. in Sec. SW SW SW

Geol.

Contr.

Pool SW Hilgers

COMPLETE

0

Date Comm. 4-12-55 JUN 8 1955

8" @ 252/150 DST 3233-85 open 1 hr.

Rec. 840' gip 40' clean oil

270' so & gcmw 1290/20" DST 3588-3623

open 1 hr. Rec. 600' gcm 500 mcfg

120' sw 1350/12" DST 3964-87

open 1 hr. 3300' gip Rec. 40' so & gcm

60' hocm 200' clean oil 100' wtr.

1540/20" 5½" @ 4039/175 CO to 4025

OVER

Co. Lse. No. Sec. T. R.

16/ 4017-20 FU 1500' oil 13 hr.

S/ 3 boph 4 hr. Comp. 23 bopd

