DX 78-1


Reno

KANSAS

Section 29 Township 26 Range 4 W

Well No. #2 A. J. Guebelle

Company Fleming-Woodamn & Frank Oyster

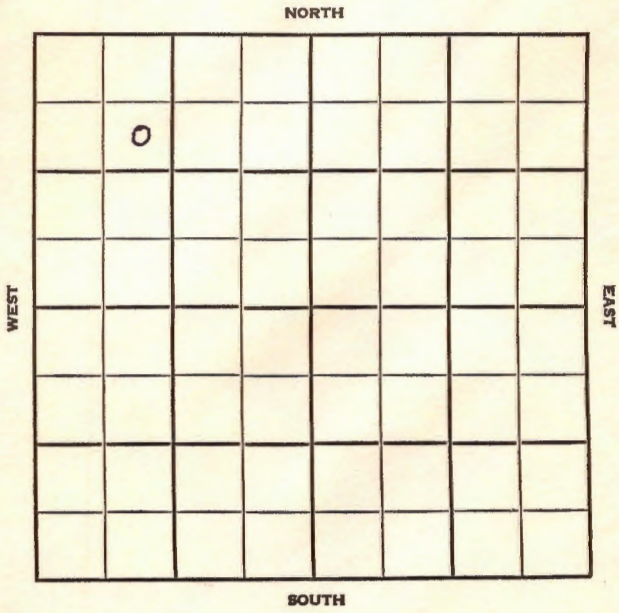

Reno KANSAS

SEC.	TWP.	R.
29	26	4W

WELL NO. 2 A. J. Guebelle FARM

COMPANY Fleming-Woodman & Frank Oyster

CONTRACTOR Co. Tools


SW Hilger

_____ Ft. from N. Line

_____ Ft. from S. Line

_____ Ft. from E. Line

_____ Ft. from W. Line

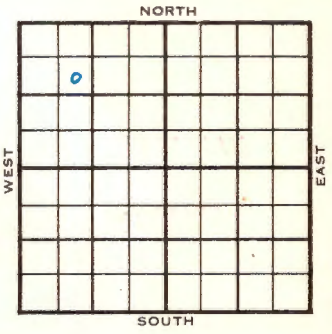

SE NW NW

1955	ELEVATION 1436' REPORT
10/5	Cellar & Pits
11-16	Comm. 10-6-55 8 5/8" @ 246 DST 3960-65 op 1 hr. gas to surface in 25 min., rec 1860' oil, 1215/20" DST 4013-19 op 1 hr. rec. 250' oil 1420/20" 5½" @ 4044 CO to 4025 16/ 4015-17, 250 A, 3/4 boph 5 hr. 250 A, S/ 63 bo 6 hr., FU 2500' oil 8 hr. Comp. 80 bopd Tops: B.L. 2784 L. 2826 M. 3600 Mz. 3960 V. 4014 S. 4024 T.D. 4045'. COMPLETED

DX-78

FORM 513 REV. SUNRAY

County Reno Elev.

Sec. 29 Twp. 26 Rge. 4W

Company Fleming-Woodman & Frank Oyster

Farm Name A. J. Guebelle No. 2

TOPS	DEPTH	LOG	DATUM
Anh.			
Tp.			
H.			
Tr.			
Dg.			
Bl.			
L.			
K.C.			
B.K.C.			
Ce.			
C.			
M.			
M.			
K.			
Mz.			
Mo.			
V.			
S.			
S.			
A			
R.			
P€.			
G.			
T.D.			

Loc. in Sec. SE NW NW

Geol.

Contr. Co. tools

Pool SW Hilger

FIRST REPORT

OCT 5 55

Date Comm.

Cellar & pits

Co. Lse. No. Sec. T. R.

FORM 513 REV. SUNRAY

County Reno Elev. 1436

Sec. 29 Twp. 26 Rge. 4W

Company Fleming-Woodman & Frank Oyster

Farm Name A. J. Guebelle No. 2

TOPS	DEPTH	LOG	DATUM
Anh.			
Tp.			
H.			
Tr.			
Dg.			
Bl.	2784		1348
L.	2826		1390
K.C.			
B.K.C.			
Ce.			
C.			
M.	3600		2364
M.			
K.			
Mz.	3960		2524
Mo.			
V.	4014		2578
S.	4024		2588
S.			
A			
R.			
Pe.			
G.			
T.D.	4045		

Loc. in Sec. SE NW NW

Geol.

Contr. Co. tools

Pool SW Hilger

COMPLETE

Date Comm. 10-6-55 NOV 16 1955

8 5/8" @ 246 DST 3960-65 open 1 hr.

gas to surface in 25 min. Rec. 1860'

oil 1215/20" DST 4013-19 open 1 hr.

rec. 250' oil 1420/20" 5½" @ 4044

CO to 4025 16/ 4015-17 250 A

3/4 boph 5 hr. 250 A S/ 63 bo

6 hr. FU 2500' oil 8 hr.

Comp. 80 bopd

Co. Lse. No. Sec. T. R.