


Section 9 Township 26 Range 4-W

Well Number 5 - Amos Rodgers

Company Magnolia

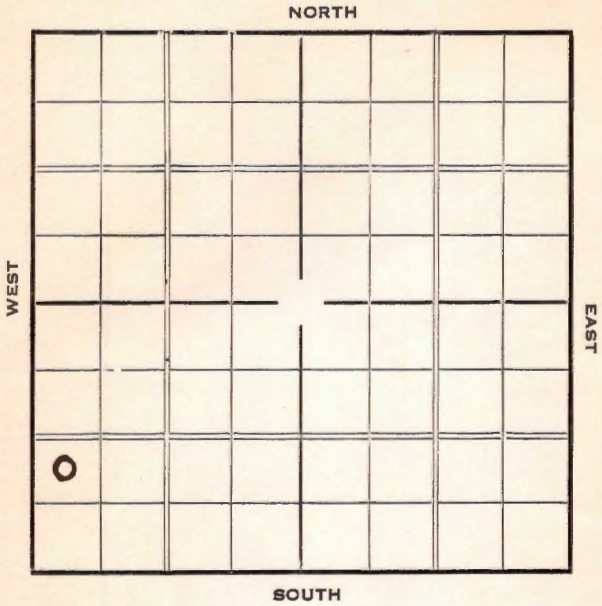

Sec. 9 Twp. 26 R. 4-W

Well No. #5 Amos Rodgers Farm  
Magnolia Company


           Ft. from N. Line

990 Ft. from S. Line

           Ft. from E. Line

330 Ft. from W. Line

**Elev. 1501**

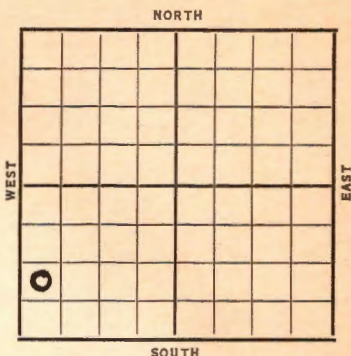

Date	REPORT
1937	
5/19	Location
5/28	Rig'n up
6/4	12" @ 200'. Drlg. 1862'.
6/11	Drlg. 3300'.
6/19	<b>Cha t 3615'</b> . Drlg. 3955'.
6/25	7" @ 4023'. RUST.
7/2	" - " " "
7/7	7" @ 4023'.
	<b>Viola 4028'</b> .
	T.D. 4032'.
	Potential 560 bbls.
	<b>COMPLETED</b>

*Reno* **KANSAS**

Map No. 40 Sec. 9 Twp. 26 R. 4<sup>w</sup>

Well No. 5-Amos Rodgers

Magnolia Company

Contractor

### FIRST REPORT

### SECTION PLAT

\_\_\_\_\_ Ft. from N. Line

990 Ft. from S. Line

\_\_\_\_\_ Ft. from E. Line

330 Ft. from W. Line

0			

Location ✓

Rig up \_\_\_\_\_

Drilling and Remarks:

### RECORD

Cased \_\_\_\_\_ in., \_\_\_\_\_ ft.

Sand \_\_\_\_\_

Gas \_\_\_\_\_

Oil \_\_\_\_\_

Total Depth \_\_\_\_\_

### PRODUCTION

1st 24 hrs. Nat. \_\_\_\_\_

1st 24 hrs. after shot \_\_\_\_\_

Gas \_\_\_\_\_ Cu. Ft.

Dry Hole \_\_\_\_\_

Abandoned \_\_\_\_\_

Date **MAY 19 1897**

H: **B. Hatfield**

Scout

*Reno* **KANSAS**

Map No. 40 Sec. 9 Twp. 26 R. 4 <sup>W</sup>

Well No. 5- Amos Rodgers

Magnolia Company

Contractor

**SECTION PLAT**

**COMPLETED**

0			

\_\_\_\_\_ Ft. from N. Line

990 Ft. from S. Line

\_\_\_\_\_ Ft. from E. Line

330 Ft. from W. Line

Location \_\_\_\_\_

Rig up \_\_\_\_\_

Drilling and Remarks:

*pt - 560*

**RECORD**

Cased 7 in., 4023 ft.

Sand Violet 4028

Gas \_\_\_\_\_

Oil \_\_\_\_\_

Total Depth 4032

**PRODUCTION**

1st 24 hrs. Nat. \_\_\_\_\_

1st 24 hrs. after shot \_\_\_\_\_

Gas \_\_\_\_\_ Cu. Ft.

Dry Hole \_\_\_\_\_

Abandoned \_\_\_\_\_

Date

**JUL 7 1937** 19

**H. D. Hatfield** Scout