

Section 17 Township 26 Range 4 W
Well No. # 1 Hilger
Company W. L. Hartman

NORTH

WEST

EAST

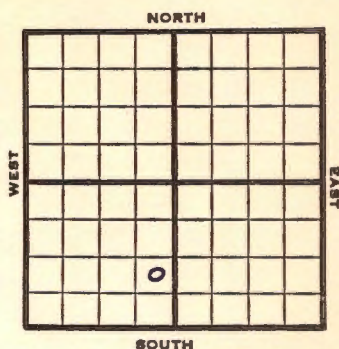
0

SOUTH

Reno

KANSAS ✓Sec. 17 Twp. 26 R. 4WWell No. #1 Hilger FarmW. L. Hartman CompanyHartman
Wildcat Contractor Ft. from N. Line990 Ft. from S. Line330 Ft. from E. Line Ft. from W. Line

NE SE SW

1952 **Elev. 1446'** REPORT

11/19 Spud 11-14-52
8" @ 153'
Drlg. 1167'

11/27 **Lans 2814'**
Drlg. 3216'

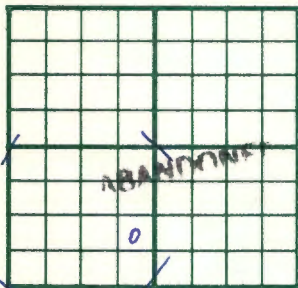
12/4 Drlg. 3570

12/11 Miss 3589 0/ 3810

12/18 KH 3882 V 4014 Simp 24029 TD 4161 Schl
D&A Hold

12/23 Spud 11-14-52
D & A TD 4161' 8" @ 153
Br. lime 2784' Lans. 2814'
Miss. 3589' Kh. 3882' Viola 4014'
Simp. 4029' Arb. 4134' TD 4161'
D & A

ABANDONED

County Reno State KansasSec. 17 (Blk.
Twp.) 26 (Sur.
Rge.) 4W Map No.Operator W. L. HartmanWell No. 1 Farm HilgerElev. 1446 Location NE SE SW990 Ft. From S Line SW330 Ft. From E Line Quarter

1st. Report

Completion DEC 23 1952Remarks WildcatHartman - Contr.Spudding Date 11-14-52Drlg. Data D & A TD 41618" @ 153 Br. lime 2784 Lans. 2814Miss. 3589 Kh. 3882 Viola 4014Simp. 4029 Arb. 4134 TD 4161D & A

County **Reno** State **Kansas**Sec. **17** (Blk. Twp.) **26** (Sur. Rge.) **4W** Map No.Operator **W. L. Hartman**Well No. **1** Farm **Hilger**Elev. Location **NE SE SW**

FIRST REPORT

0

990 Ft. From **S** Line **SW****330** Ft. From **E** Line **Quarter**1st. Report **NOV 19 1952**

Completion

Remarks

Hartman - Contr.Spudding Date **11-14-52**Drlg. Data **Wilcoat****8" 153 drlg. 1167**