


Section 17 Township 26 Range 4-W

Well No. #3 Thome

Company Magnolia

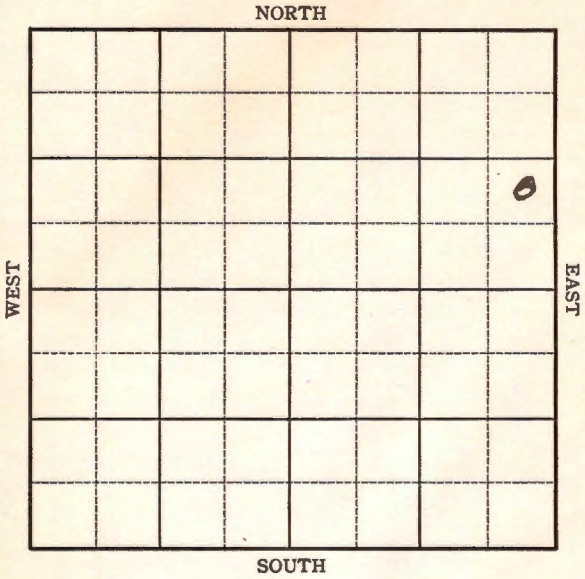

Sec. 17 Twp. 26 R. 4-W

Well No. #3 Thone Farm


Magnolia et al Company

_____ Ft. from N. Line

990 Ft. from S. Line

330 Ft. from E. Line

_____ Ft. from W. Line

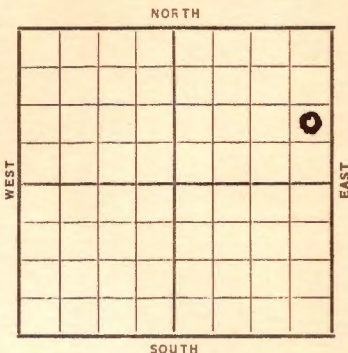

Date	REPORT
1937	
10/20	13" @ 182'. WOC.
10/29	Drlg. 2500'.
11/5	Chat 3615' . Drlg. 3842'.
11/12	Misner 3985' . 7" @ 4010'. C.O.
11/19	Viola 4032' . T.D. 4033'.
	40' oil 8 hrs. 250 acid.
	1000 acid. H.F.W. S.D.O.
11/26	" " " " "
12/1	7" @ 4010'.
	Misner 3985' .
	T.D. 4033'.
	1250 acid.
	H.F.W.
	COMPLETED

