

Reno

KANSAS

DX 78-1

Section 19 Township 26 Range LW

Well No. #1 M. Martin

Company Sun Oil

NORTH

							0

WEST

EAST

SOUTH

Reno KANSAS

SEC.	TWP.	R.
19	26	LW

WELL NO. **1 M. Martin** FARM

COMPANY **Sun Oil Co.**
--Transit--


CONTRACTOR **Transit**

_____ Ft. from N. Line

330 _____ Ft. from S. Line

330 _____ Ft. from E. Line

_____ Ft. from W. Line

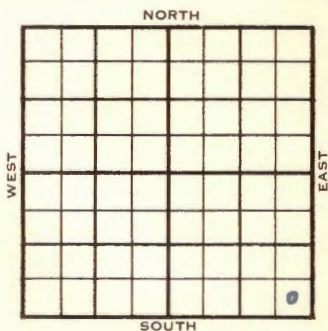

SE SE SE

	ELEVATION	REPORT
1955	1438'	

3/9 Spud 3-5-55
8" @ 286'
Drlg. 1237'

8/31 Comm 3-5-55
B1 28 2787
L 2831
Miss 3604
V 4016

8" @ 286 w/250
DST 3969-79 45" Rec 20' mud BHP O#
5 1/2" @ 4025 w/125 Drlg plug
CO 4023 12/4018-21 Swb 11.8 bo
no wtr 11 hrs 250 acid
Swb 86 bo 25 bw 10 hrs Swb 13 1/2 bo
67 bw 24 hrs Swb 64 bo 82 bw 24 hrs
Swb 48 bo 77 bw 24 hrs POP Pmp 15
bopd plus 15 bwpd Pmp 3 bo plus 30
bwpd P 6 bopd no wtr.

COMPLETED

County ~~Reno~~ Elev. 1438 DF

Sec. ~~19~~ Twp. 26 Rge. 4W

Company Sun Oil Co.

FarmName M. Martin No. 1

TOPS	DEPTH	LOG	DATUM	Loc. in Sec.
Anb.				SE SE SE
TP.				
H.				
Tr.				
Dg.				
Bl.	2787		1349	
L.	2831		1393	Geol.
K.C.				Contr.
B.K.C.				Transit
Ce.				
C.				
M.				
M.iss	3604		2166	Pool
K.				
Mz.				
Mq.				
V.	4016		2578	
S.				
S.				
A.				
R.				
PE.				
G.				
T.D.				

COMPLETE

Date Comm. 3/5/55 AUG 31 1955

8" 286 w/250 DST 3969-79 45" Rec. 20'

mud BHP Off

5 1/2" 4025 w/125 Drlg plug CO 4023 12/4018-

21 Swb 11.8 bo no wtr 11 hrs. 250 acid

Swb 86 bo 25 bw 10 hrs Swb 13 1/4 bo 67 bw

24 hrs. Swb 64 bo 82 bw 24 hrs Swb 48

bo 77 bw 24 hrs POP Pmp 15 bopd plus

15 bwpd Pmp 3 bo plus 30 bwpd

P 6 bopd no wtr