

Reno


KANSAS

SECTION 20 TOWNSHIP 26 RANGE 4 W

WELL NO. #2 C. J. Guebelle

COMPANY Fleming & Woodman

NORTH

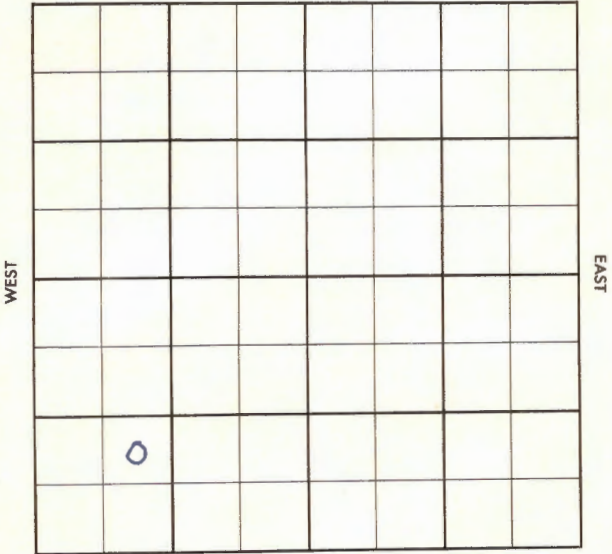

SOUTH

Reno

KANSAS

SEC.	TWP.	R.
20	26	4W

WELL NO. #2 C. J. Guebelle FARM

COMPANY Fleming & Woodman


CONTRACTOR Co Tools
SW Hilger

_____ Ft. from N. Line

_____ Ft. from S. Line

_____ Ft. from E. Line

_____ Ft. from W. Line

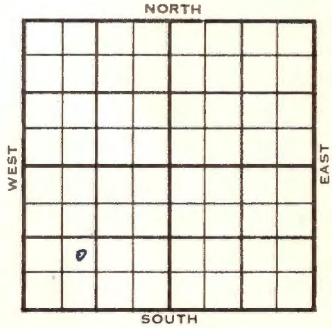

NE SW SW

	ELEVATION	REPORT
1955	1449	

11/2 Comm 10-27-55
8" @ 250/135
Drlg 2245

1956

2-1 DST 3242-55 op 1 hr. rec. 160' gcm,
60' o&gcm, 60' sw, 1370/20"
DST 3600-27 op 1 hr. gas in 10 min.
63 mcf rec. 330' gcm, 360' ~~##~~ gcw
1180/20"
5 1/2" @ 4033/100
CO to 4034 1 bfph, 8 hrs., 10% wtr.
SP 4028, 20/ 3982-85,
FU 2900' oil,
S/ 87 bo 1 1/2 hr.,
Comp. 82 bopd
BL 2801
L. 2844
M. 3593
K. 3900
Mz. 3977
V. 4032
TD 4034

COMPLETED

County Remo Elev. _____
 Sec. 20 Twp. 26 Rge. LW
 Company Fleming & Woodman
 Farm Name C. J. Guebelle No. 2

TOPS	DEPTH	LOG	DATUM	Loc. in Sec.
Anh.				NE SW SW
Tp.				
H.				
Tr.				
Dg.				
Bl.				
L.				Geol. _____
K.C.				Contr. _____
B.K.C.				
Ce.				Co. tools
C.				
M.				Pool
M.				SW Hilger
K.				
Mz.				
Mq.				
V.				
S.				
S.				
A.				
R.				
Pe.				
G.				
T.D.				

FIRST REPORT
 NOV 2 '55

Date Comm. 10-27-55
8" @ 250/135 drlg. 2245

~~28~~

Co.
 Sec.
 No.
 Sec.
 T.
 R.

County Reno Elev. 1449
 Sec. 20 Twp. 26 Rge. 4W
 Company Fleming & Woodman
 Farm Name C. J. Guebelle No. 2

TOPS	DEPTH	LOG	DATUM	Loc. in Sec.
Anh.				NE SW SW
Tr.				
Dg.				
Bl.	<u>2801</u>		<u>1352</u>	
L.	<u>2844</u>		<u>1395</u>	Geol.
K.C.				Contr.
B.K.C.				Co. tools
Ce.				
C.				
M.	<u>3593</u>		<u>2144</u>	Pool
M.				SW Hilger
K.	<u>3700</u>		<u>2457</u>	
Mz.	<u>3777</u>		<u>2528</u>	
Me.				
V.	<u>4032</u>		<u>2583</u>	
S.				COMPLETE
S.				
A.				
R.				
Pe.				
G.				
T.D.	<u>4034</u>			

Date Comm. 10-27-55 FEB 1 1956
 8" @ 250/135 DST 3242-55 open 1 hr.
 rec. 160' gcm 60' o & gcm 60' sw
 1370/20" DST 3600-27 open 1 hr.
 gas in 10 min., 63 mcf rec. 330' gcm
 360' gcw 1180/20" 5 1/2" @ 4033/100
 CO to 4034 1 bfph 8 hr. 10% wtr.
 SP 4028 20/ 3982-85 FU 2900' oil
 S/ 87 bo 1 1/2 hr. Comp. 82 bopd

Co.
Lse.
No.
Sec.
T.
R.