

Reno

KANSAS

SEC. 21	TWP. 26	R. 4W
------------	------------	----------

WELL NO. #1 Al Meyer FARM

COMPANY Skelly Oil Co.

CONTRACTOR Wentworth


WILDCAT

_____ FT. FROM N. LINE

_____ FT. FROM S. LINE

_____ FT. FROM E. LINE

_____ FT. FROM W. LINE

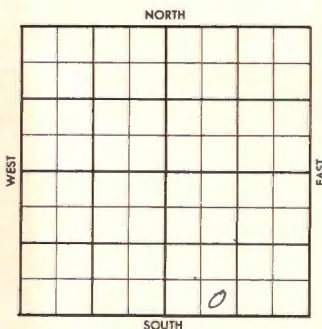

SE SW SE

1956	ELEVATION 1468'	REPORT
------	--------------------	--------

6-13 Comm. 6-8-56
8" @ 736 w/150
WOC

7-B DST 3106-67 op 1 hr. rec. 30' mud,
BHP 1073/20".
DST 3181-3201 op 1 hr. rec. 20' SOCM /
60' oil spkd SW / 180' SW, BHP 1280/20"
DST 3209-25 op 1 hr., rec. 30' mud, /
120' msw, BHP 1260/20".
DST 3245-63 op 1 hr., rec. 760' SW,
1340/20"
DST 3980-4040 op 1 hr. rec. 3' mud,
BHP 90/20".
DST 4035-56 op 1 hr. rec. 30' ocm / 60'
socs w / 240' spotted oily SW / 1200'
SW, BHP 1440/20"
DST 4059-64 op 1 hr., rec. 2970' SW,
BHP 1400#.
D & A
L. 2831', M. Li. 3617', Mz, 4026'.
V. 4042', S.Sd. 4058', A. 4162-4210'.
TD 4210'.

ABANDONED

County Reno Elev. 1468
 Sec. 27 Twp. 26S Rge. 1W
 Company Skelly Oil Co.
 Farm Name Al Meyer No. 1

TOPS	DEPTH	LOG	DATUM	Loc. in Sec.
Anh.				SE SW SE
Tr.				
H.				
Tr.				
Dg.				
Bl.				
L.	2831			Geol.
K.C.				Contr.
B.K.C.				
Ce.				
C.				Wentworth
M. 61	3617			Pool
M.				W.C.
K.				
Mz.	4026			
Me.				
V.	4042			
S. 3d	4058			
S.				
A.	4162-4210			
R.				
Pe.				
G.				
TD	4210			

ABANDONED

Date Comm. 6/8/56 JUL 3 1956

8th 736 w/150 WOC JUN 20 '56 $\bar{\phi}$ 2950
 JUN 27 '56 DST 3106-67 op 1hr rec
 30' Md BHP 1073/20" DST
 3181-3201 1hr rec 20' 50CM
 + 60' oil spkd SW + 180' SW
 BHP 1280/20" DST 3209-25
 op 1hr rec 30' Md + 130' M SW
 BHP 1260/20" DST 3245-63 op 1hr
 rec 760' SW 1340/20" $\bar{\phi}$ 3844

21-26-4W SESWSE

DST 3980-4040 1hr run

3' Md BHP 90/20" DST

4035-56 1hr run 30' OCM +

60' 500 SW + 240' spotted oily

SW. + 1200' SW BHP 1440/20"

DST 4059-64 or 1hr run

2970' SW BHP 1400

D&A

21-26-4W

SESWSE