
DX 78-1

Reno KANSAS

Section 29 Township 26 Range 4W

Well No. 1 Geubelle

Company Fleming & Woodman & Frank Oyster

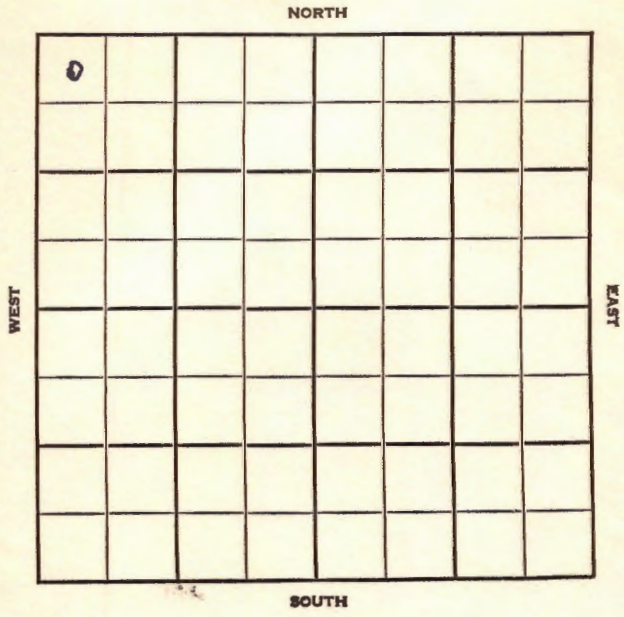

Reno KANSAS

SEC.	TWP.	R.
29	26	4 W

WELL NO. # 1 Gaubelle FARM

COMPANY Fleming & Woodman & Frank Oyster

CONTRACTOR Felming & Woodman

Wildcat


330 Ft. from N. Line

Ft. from S. Line

Ft. from E. Line

330 Ft. from W. Line

NW NW NW

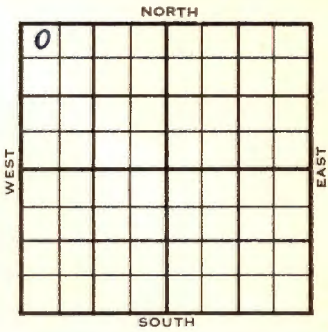

Sun-Support

1955	ELEVATION 1439' REPORT
1/19	Spud 1-17-55 8" @ 251 WOC
3/16	Spud 1-17-55, Oil Well, TD 4033 8" @ 251, Br Lime 2791, Lans 2834, DST 3050-78, open 65 min, Rec 50' SGCM 990#, Miss 3582 DST 3583-3608 open 45 min. Rec 220' mud 1305# DST 3608-25, open 1 hr gas in 6 min. 1,500,000 cfg in 30 min. Rec 100' HOCM 30' wtr. 1315# KH 3885, Misener 3960, Viola 4012, DST 4012-21, open 1 hr gas in 20 min. Rec 3500' free oil, 1370# Simp 4024, DST 4025-32 open 45 min. Rec 35' mud 1290# TD 4033 5" @ 4028 CO to 4022, 24/4012-16, FU 120' oil 1 hr. 140' oil 40 min, 150 M-A FU 1300' oil S/2 to 3 BOPH 250 A F/30 BOPH P & F/ 70 BO 12 hr Comp 232 BOPD 4% wtr, COMPLETED

DX-78

FORM 275 FOR SALE BY KANSAS BLUE PRINT CO.


County Reno State Kansas

Sec. 29 (Blk. Twp.) 26 (Sur. Rge.) 4W Map No.

Operator Fleming & Woodman & Frank Oyster

Well No. 1 Farm Geubelle

Elev. 1439 Location NW NWNW

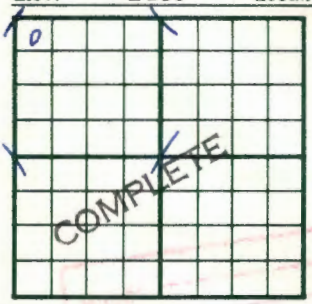

330 Ft. From N Line NW

330 Ft. From W Line Quarter

1st. Report

Completion MAR 1 6 1955

Remarks SW Hilger Pool

Fleming & Woodman - Contr.

Spudding Date 1-17-55

Drlg. Data Oil well TD 4033

8" @ 251 Br. lime 2791 Lans. 2834

DST 3050-78 open 65 min. Rec. 50' sgcm

990# Miss. 3582 DST 3583-3608

open 45 min. Rec. 220' mud 1305#

DST 3608-25 open 1 hr. gas in 6 min.

1,500,000 cfg in 30 min. Rec. 100' hocm

30' wtr. 1315# Kh. 3885 Misener 3960

Viola 4012 DST 4012-21 open 1 hr.

gas in 20 min. Rec. 3500' free oil

1370# Simp. 4024 DST 4025-32

open 45 min. Rec. 35' mud 1290#

TD 4033 5" @ 4028 CO to 4022

24/ 4012-16 FU 120' oil 1 hr. 140' oil

40 min. 150 M-A FU 1300' oil

FABEN GILOVER

FORM 275 FOR SALE BY KANSAS BLUE PRINT CO.


County Reno State Kansas

Sec. 29 (Blk. / Twp.) 26 (Sur. / Rge.) 4W Map No.

Operator Fleming & Woodman & Frank Oyster

Well No. 1 Farm Geubelle

Elev. Location NW NW NW

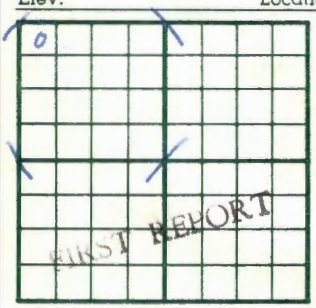

330 Ft. From N Line NW

330 Ft. From W Line Quarter

1st. Report JAN 19 1955

Completion

Remarks Sun - support
Fleming & Woodman - Contr.

Spudding Date 1-17-55

Drlg. Data Wildcat

8" @ 251 WOC

FABEN GILSTRAP

Drlg. Data

S/ 2 to 3 boph 250 A F/ 30 boph

P & F/ 70 bo 12 hr.

Comp. 232 bopd 4% wtr.

