
KANSAS

Reno

SECTION 29 TOWNSHIP 26 RANGE 4 W

WELL NO. #3 A. J. Guebelle

COMPANY Fleming & Woodman et al

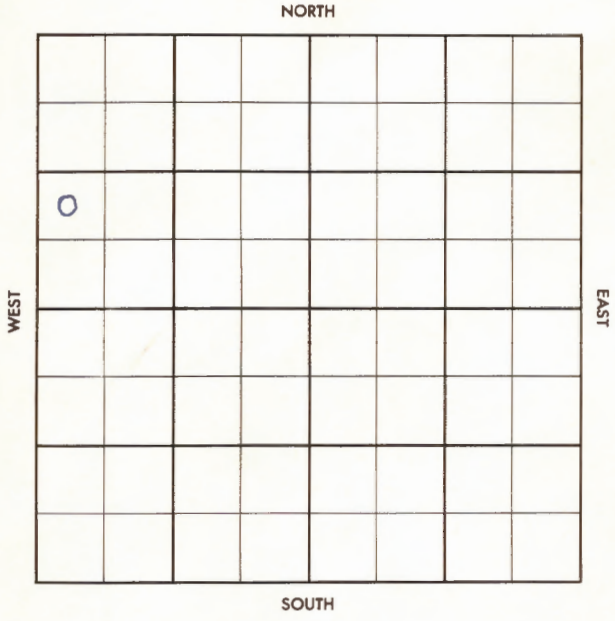

FORM 504-3 SUNRAY

Reno KANSAS

SEC.	TWP.	R.
29	26	4W

WELL NO.

#3 A. J. Gusbelle FARM

COMPANY

Fleming & Woodman et al

CONTRACTOR

Co Tools
SW Hilgers


_____ Ft. from N. Line

_____ Ft. from S. Line

_____ Ft. from E. Line

_____ Ft. from W. Line

NW SW NW

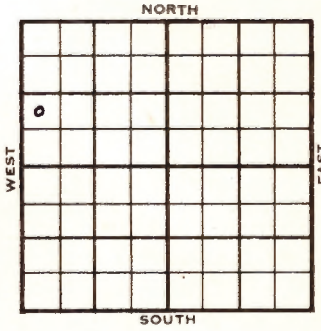

1955	ELEVATION	REPORT
11/16		Comm 11-14-55 8m @ 250/150 WOC

DX-78

FORM 513 REV. SUNRAY

County Reno Elev.

Sec. 29 Twp. 26 Rge. 4W

Company Fleming & Woodman etal.

Farm Name A. J. Cuebelle No. 3

TOPS	DEPTH	LOG	DATUM
Anh.			
T.p.			
H.			
Tr.			
Dg.			
B.L.			
L.			
K.C.			
B.K.C.			
Ce.			
C.			
M.			
M.			
K.			
Mz.			
Me.			
V.			
S.			
S.			
A			
R.			
P€.			
G.			
T.D.			

Loc. in Sec. NW SW NW

Geol.

Contr. Co. tools

Pool SW Hilgers

FIRST REPORT

NOV 16 1955

Date Comm. 11-14-55

8" @250/150 WOC

Co. Lse. No. Sec. T. R.