


Reno

KANSAS

SECTION 30 TOWNSHIP 26 RANGE 4W

WELL NO. #1 Lenhart

COMPANY McNeish & Gralapp

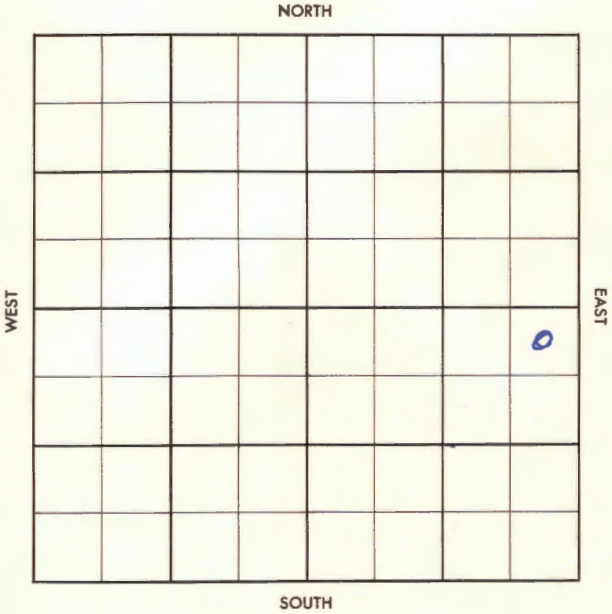

Reno

KANSAS

SEC.	TWP.	R.
30	26	4W

WELL NO.

#1 Lenhart

FARM

COMPANY

McNeish & Gralapp

CONTRACTOR

Watson

SW Hilgers


Ft. from N. Line

Ft. from S. Line

Ft. from E. Line

Ft. from W. Line

NE NE SE

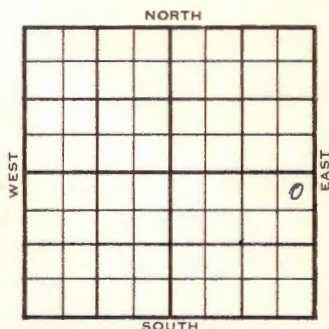

Fleming-Woodman - FO

1956	ELEVATION	REPORT
	1440'	

5-2 Comm. 5-1-56

5-23 8 5/8" @ 224
D & A

BL. 2796', L. 2840', M. 3610'.

Log tops:

L. 2844', M. 3610', K. 3899', ~~Mz~~

Mz. Zn. 3974', V. 4037', S. 4050'.

TD 4058'

ABANDONED

County Reno Elev. 1440
 Sec. 30 Twp. 26 Rge. 4W
 Company McNeish & Gralapp
 Farm Name Lenhart No. 1

TOPS	DEPTH	LOG	DATUM	Loc. in Sec.
Anb.				NE NE SE
Tp.				
H.				
Tr.				
Dg.				
BL.	2796			
L.	2840	2844		Geol.
K.C.				Contr.
B.K.C.				Watson
Ce.				
C.				
M.	3610	3610		
M.				Pool
K.		3899		SW Hilgers
M.	27	3974		
Me.				
V.		4032		
S.		4050		
S.				
A.				
R.				
Pe.				
G.				
T.D.	4058			

ABANDONED
 MAY 28 1956

Date Comm. 5-1-56 Fleming-Woodman - FO

MAY 9 '56 2800 MAY 15 '56 878 224

3650 MAY 23 '56

DEA

County Reno Elev. _____
 Sec. 30 Twp. 26 Rge. 4W
 Company McNeish & Gralapp
 Farm Name Lenhart No. 1

TOPS	DEPTH	LOG	DATUM	Loc. in Sec. _____
Anb.				NE NE SE
Tp.				
H.				
Tr.				
Dg.				
Bl.				
L.				Geol. _____
K.C.				Contr. _____
B.K.C.				Watson
Ce.				Pool _____
C.				SW Hilgers
M.				
M.				
K.				
Mz.				
Mq.				
V.				
S.				
S.				
A.				
R.				
Pe.				
G.				
T.D.				

FIRST REPORT

MAY 2 '56

Date Comm. 5-1-56 Fleming-Woodman - FO

28