
KANSAS Reno

FORM 51 10M 8-47

Section 31 Township 26 Range 4-W

Well No. #1 Eck

Company Phillips & Magnolia

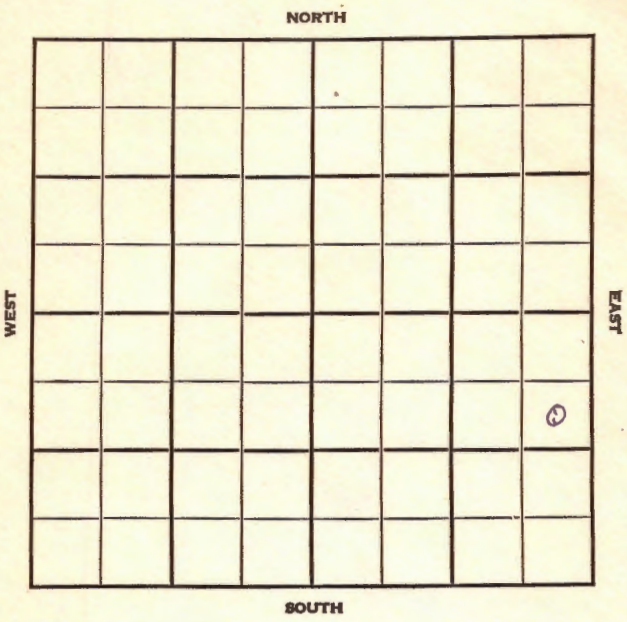

FORM 252-A
5M 4-48 PETROL

KANSAS

Reno

Sec. 31 Twp. 26 R. 4W

Well No. #1 Eck Farm

Phillips & Magnolia Company

Wildcat


990' Ft. from N. Line

_____ Ft. from S. Line

330' Ft. from E. Line

_____ Ft. from W. Line

SE NE SE

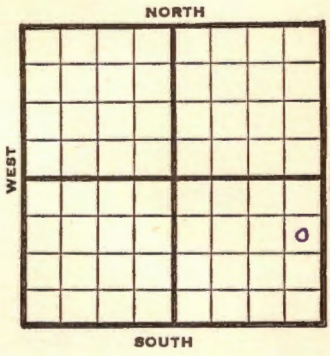

1948	REPORT
	Eli 1418'
7/8	RUR
7/14	"
7/21	8"@ 354' Drlg 2230'
7/28	Lansing 2831' Drlg 3540'
8/4	Mississippi 3611' Misener 3967' Viola 4023' TD 4027-200' oil.
8/11	"
8/18	300 acid swb 8½ bbls / 6½ W in 5 hrs.
8/25	"
9/1	"
9/8	"
9/14	"
9/21	"
9/29	TD 4036' Simpson 4035' Aband.

ABANDONED

Form 26—200 Bks.—1-48—Palace

Wildcat

Kansas

Map No. _____ Sec. 31 Twp. 26 R. 4W

Well No. 1 Eck

Phillips & Magnolia Company

FIRST REPORT Contractor

SE NE SE


990 Ft. from N. Line

_____ Ft. from S. Line

330 Ft. from E. Line

_____ Ft. from W. Line

SECTION PLAT

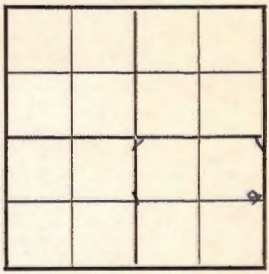

Reno County

Location _____

Rig up _____

Drilling and Remarks:

R U R

RECORD

Cased _____ in., _____ ft.

Sand _____

Gas _____

Oil _____

Total Depth _____

PRODUCTION

1st 24 hrs. Nat. _____

1st 24 hrs. after shot _____

Gas _____ Cu. Ft.

Dry Hole _____

Abandoned _____

Date

JUL 8 1948 19

S. J. LEWIS Scout

Form 26—200 Bks.—1-48—Palace

Kansas

Wildcat

Map No. 40 Sec. 31 Twp. 26 R. 4W

Well No. 1 Eck


Phillips & Magnolia Company

ABANDONED Contractor

SE NE SE

El. 1415'

SECTION PLAT

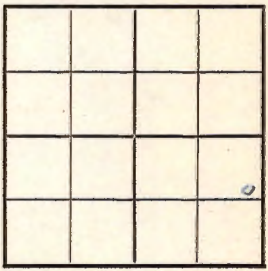

990 Ft. from N. Line

Ft. from S. Line

330 Ft. from E. Line

Ft. from W. Line

Reno County

Location

Rig up

Drilling and Remarks:

Surface 1035'

RECORD

Cased in., ft.

Sand

Gas

Oil

Total Depth 4036

PRODUCTION

1st 24 hrs. Nat.

1st 24 hrs. after shot

Gas Cu. Ft.

Dry Hole

Abandoned

Date

SEP 29 1948 19

S. J. LEWIS Scout