


Reno

KANSASSection 31 Township 26 Range 4WWell No. #1 TheisCompany Eldorado Ref.

NORTH

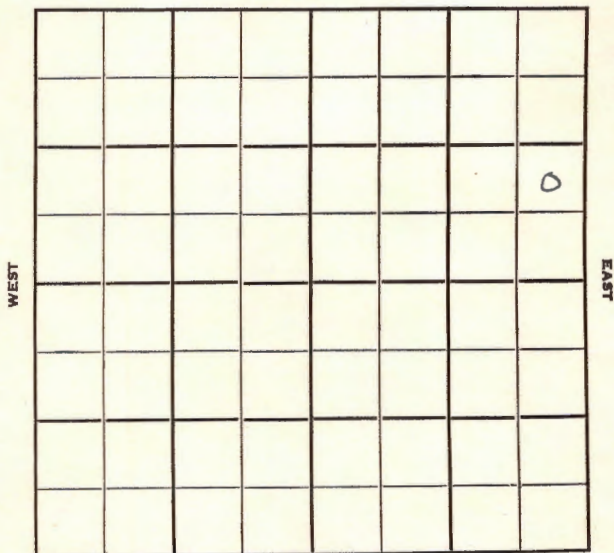

WEST

EAST

SOUTH

Reno

KANSAS 4W

Sec. 31 Twp. 26 R. 4W

Well No. #1 Theis Farm

El Dorado Refg. Company

Wildcat Contractor


 Ft. from N. Line

990' Ft. from S. Line

330' Ft. from E. Line

 Ft. from W. Line

NE SE NE

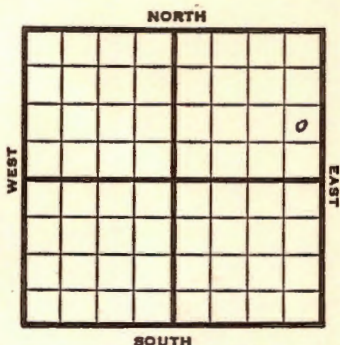

1951

Elev. 1420' REPORT

5/16

RUR

7/3

Spud 6-3-51

D&A TD 4180

8" @ 265

Lan. 2831 Miss 3606

Viola 4025

DST 4026-30 opn 1 hr

Rec. 10' mud **Simp 4040**

Arb. 4145 TD 4180

D&A

ABANDONED

County **Reno** State **Kansas**Sec. **31** (Blk.) **26** (Sur.) **4W** Map No.Operator **Eldorado Ref.**Well No. **1** Farm **Theis**Elev. Location **NE SE NE**

FIRST REPORT

990 Ft. From **8** Line **NE****330** Ft. From **E** Line Quarter1st. Report **MAY 16 1951**

Completion

Remarks **Phillips DHM**


Spudding Date

Drig. Data **Wildcat****RUR**

J. E. TYRA

County Reno State Kansas
 Sec. 31 (Blk. 26) (Sur. 4W) Map No.
 Operator Eldorado Ref.
 Well No. 1 Farm Theis

Elev. 1420 Location NE SE NE

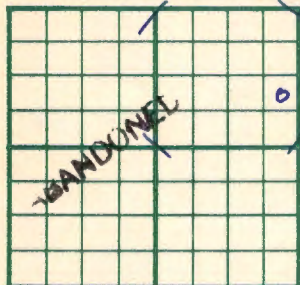

990 Ft. From S Line NE

330 Ft. From E Line Quarter

1st. Report

Completion JUL 3 1951

Remarks Wildcat

Spudding Date 6-3-51

Drig. Data D & A TD 4180

8" @ 265 Lans. 2831 Miss. 3606

Viola 4025 DST 4026-30 open 1 hr.

Rec. 10' mud Simp. 4040 Arb. 4145

TD 4180 D & A