


Section 30 Township 26 Range 4W

Well No. 1 Gilger - Cron

Company Fleming & Woodman

NORTH

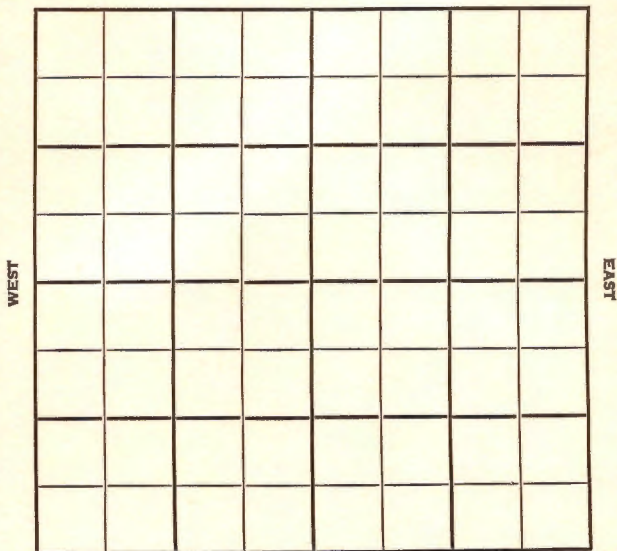

SOUTH

Reno

KANSAS

SEC.	TWP.	R.
30	26	4 W

WELL NO. # 1 Hilger-Cron FARM

COMPANY Fleming & Woodman

CONTRACTOR


SW Hilgers

_____ Ft. from N. Line

_____ Ft. from S. Line

_____ Ft. from E. Line

_____ Ft. from W. Line

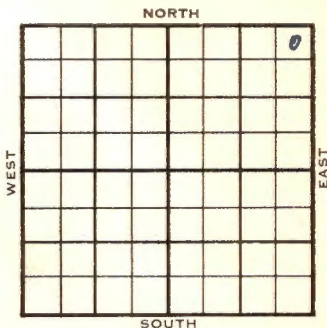

NE NE NE

	ELEVATION	REPORT
1955		

7/13

Comm. 5-19-55
 8-5/8" @ 247/200
 DST 3221-45 open 1 hr rec 70' OCM
 129-/20"
 DST 3575-3603, open 1 hr gas in 10
 min, 25 MCFG, rec 150' mud, 10' wtr.
 1185/20"
 DST 3949-64 open 1 hr gas in 15",
 rec 1700' clean oil, 1280# 5 1/2" @ 4050/
 w/100 CO to 4030 16/4008-10
 B/8 GOPH 250 A HFW SP 3970
 16/3955-57 S/38 BO 4 hr.
 S/15 BO FU 3250' oil 12 hr.
 F/27 BO 24 hrs.
 Comp. F/25 BOPD
 L. 2808', M. 3574', K 3879'
 Mz. 3954', V. 4008', S. 4020'
 TD 4050'

FIRST REPORT
 COMPLETED

County Reno Elev. 1432
 Sec. 30 Twp. 26 Rge. 4W
 Company Fleming & Woodman
 Farm Name Hilger - Cron No. 1

Co.

TOPS	DEPTH	LOG	DATUM
Anh.			
Tp.			
H.			
Tr.			
Dg.			
Bl.			
L.	<u>2808</u>		<u>1376</u>
K.C.			
B.K.C.			
Ce.			
C.			
M.	<u>3574</u>		<u>2142</u>
M.			
K.	<u>3879</u>		<u>2447</u>
Mz.	<u>3954</u>		<u>2526</u>
Ma.			
V.	<u>4008</u>		<u>2576</u>
S.	<u>4020</u>		<u>2588</u>
S.			
A.			
R.			
Pe.			
G.			
T.D.	<u>4050</u>		

Loc. in Sec. NE NE NE
 Geol. _____
 Contr. _____
 Pool SW Hilgers
 JUL 13 1955

Loc.

No.

Sec.

T.

R.

Date Comm. 5-19-55
8 5/8" @ 247/200 DST 3221-45 open 1 hr
Rec. 70' ocm 1290/20" DST 3575-3603
open 1 hr. gas in 10 min. 25 mcfg
Rec. 150' mud 10' wtr. 1185/20"
DST 3949-64 open 1 hr. gas in 15 min.
Rec. 1700' clean oil 1280# 5 1/2" @
4050/100 CO to 4030 16/ 4008-10
E/ 8 goph 250 A HFW SP 3970

OVER

16/ 3955-57 S/ 38 bo 4 hr.

S/ 15 bo FU 3250' oil 12 hr.

F/ 27 bo 24 hr. Comp. F/ 25 bopd

_____	Misc.
_____	Pierce Map
_____	France Map
_____	Tracings
_____	Lead Well Map
_____	Lead Small Map
_____	Scout Cards

W. W. W.

JUL 25 1956