


Section 3 Township 26 Range 4WWell No. #1 BurdorfCompany Derby Oil Company

NORTH

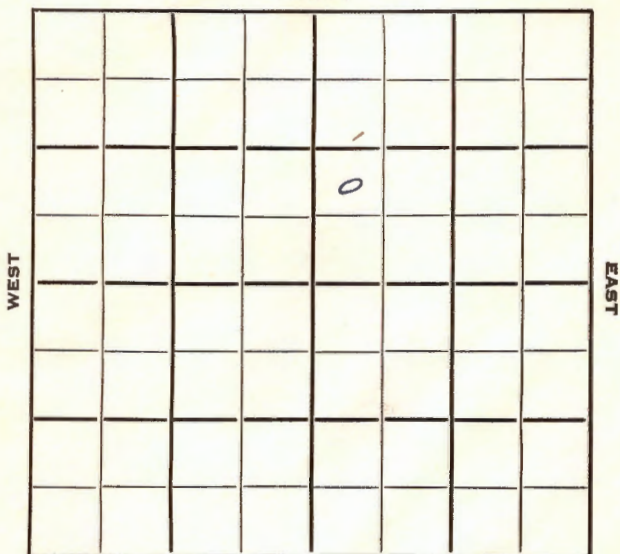

SOUTH

Reno

KANSAS

Sec. 3 Twp. 26 R. 10W

Well No. #1 Burdorf Farm

Derby Oil Company _____ Company

~~Saturn Drlg. - Contr.~~ Contractor

_Ft. from N. Line

990


Ft. from S. Line

Ft. from E. Line

330

_Ft. from W. Line

NW SW NE

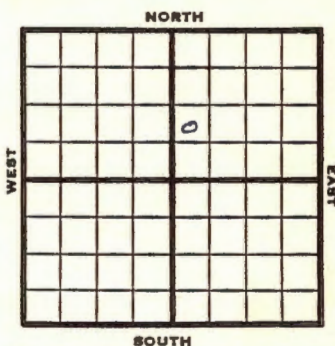

1953 Elev. 1530' REPORT

3/4 Spudded 2/28/53

8ⁿ @ 190 Drlg. 720

3/12	Heeb 2615, Br li 2810, Lans 2850
------	-------------------------------------

drlg. 3227'


3/20 Spud 2428-53 D & A TD 3360'

8" @ 190 Heeb 2615 Br. lime 2810'

Lans. 2850' B KC 3340'

TD 3360' D & A

ABANDONED

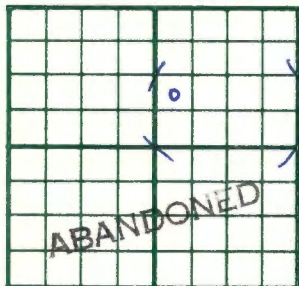County Reno State KansasSec. 3 (Blk. Twp.) 26 (Sur. Rge.) 4W Map No.Operator Derby OilWell No. 1 Farm BurdorfElev. 1530 Location NW SW NE990 Ft. From S Line NE330 Ft. From W Line Quarter1st. ReportCompletion MAR 18 1953RemarksSaturn Drlg. - Contr.Spudding Date 2-28-53Drlg. Data D & A TD 33608" @ 190 Heeb. 2615 Br. lime 2810Lans. 2850 B KC 3340 TD 3360D & A

J. G. McGEHEE