DX 78-1

Reno KANSAS

Section 3 Township 26 Range 4W

Well No. 2 Prough

Company Phillips Petr.

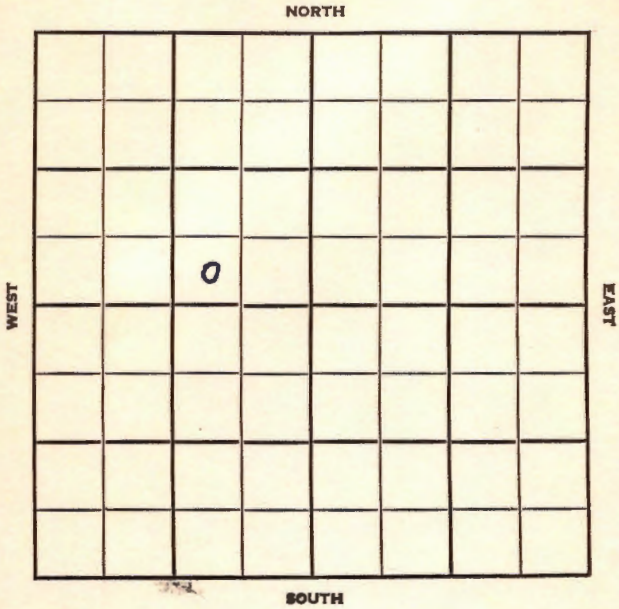

Reno KANSAS

| SEC. | TWP. | R. |
|---|---|---|
| 3 | 26 | 4 W |

WELL NO.

# 2 Prough FARM

COMPANY

Phillips Pet.

CONTRACTOR

Co. tools

Nicklaus Pool

_____ Ft. from N. Line

345 Ft. from S. Line

_____ Ft. from E. Line

1650 Ft. from W. Line

SW SE NW

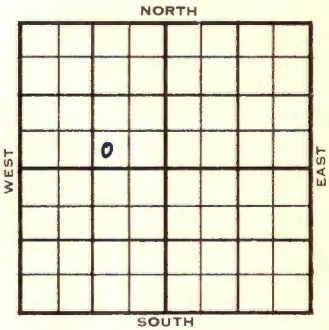


| 1954 | ELEVATION 1542' REPORT |
|---|---|
| 8/18 | Location |
| 10/13 | Spud 8-25-54 - Oil Well<br>TD 4115'<br>8-5/8" @ 325'<br>Heeb 2626', Tpr 2641', Br lime 2814',<br>Lans 2854', B KC 3348', Marm. 3356',<br>Cherokee 3537', Miss 3648'<br>DST 3692-3737', opn 1 hr., rec. 1270'<br>muddy SW, 1195#<br>Kh. 3991', Misener 4089', Viola 4105'<br>DST 4086-4106', opn 1 hr., rec. 250'<br>HOCM, 1010' oily SW, 1430#<br>DST 4105-10', opn 1 hr., rec. 150'<br>OCM, 360' oily wtr, 930' SW, 1420#<br>TD 4115'<br>5" @ 3355'<br>CO to 3322'<br>20/3251-56, 46 go 32½ gw 2 hrs., 500A<br>S/191 bo 10 hrs.<br>P/69 bo 4½ hrs.<br>P/143 bo 36 bw<br>Comp. 410 bopd 56 bw<br><br>COMPLETED |

DX-78

FORM 275 FOR SALE BY KANSAS BLUE PRINT CO.

County Reno State Kansas

Sec. 3 (Blk. / Twp.) 26 (Sur. / Rge.) 4W Map No.

Operator Phillips Pet.

Well No. 2 Farm Prough

Elev. Location SW SE NW

345 Ft. From S Line NW

1650 Ft. From W Line Quarter

AUG 18 1954

1st. Report

Completion

Remarks

Co. tools

Spudding Date

Nicklaus Pool

Drlg. Data

Location

FABEN GILSTRAP

FORM 275 FOR SALE BY KANSAS BLUE PRINT CO.

County Reno State Kansas

Sec. 3 (Blk. Twp.) 2 6 (Sur. Rge.) 4W Map No.

Operator Phillips Pet.

Well No. 2 Farm Prough

Elev. 1542 Location SW SE NW

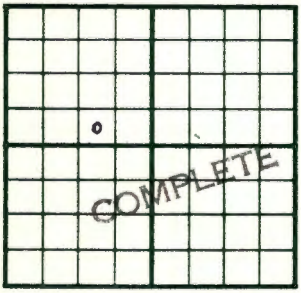


345 Ft. From S Line NW

1650 Ft. From W Line Quarter

1st. Report

Completion OCT 13 1954

Remarks Nichlaus Pool Co. tools

Spudding Date 8-25-54

Drlg. Data Oil well TD 4115

8 5/8" @ 325 Heeb. 2626 Tor. 2641

Br. lime 2814 Lans. 2854 B KC 3348

Marm. 3356 Cherokee 3537 Miss. 3648

DST 3692-3737 open 1 hr. Rec. 1270'

Muddy sw 1195# Kh. 3991 Misener 4089

Viola 4105 DST 4086-4106 open 1 hr.

Rec. 250' hocm 1010' oily sw 1430#

DST 4105-10 open 1 hr. Rec. 150' ocm

360' oily wtr. 930' sw 1420# TD 4115

5" @ 3355 CO to 3322 20/ 3251-56

46 go 32½ gw 2 hr. 500 A S/ 191 bo

10 hr. P/ 69 bo 4½ hr. P/ 143 bo

36 bw Comp. 410 bopd 56 bw

FABEN GILSTRAP