
DX 78-1

Reno County, Kansas

Section 3 Township 26S Range 4W

Well No. #3 Prough

Company Phillips Pet.

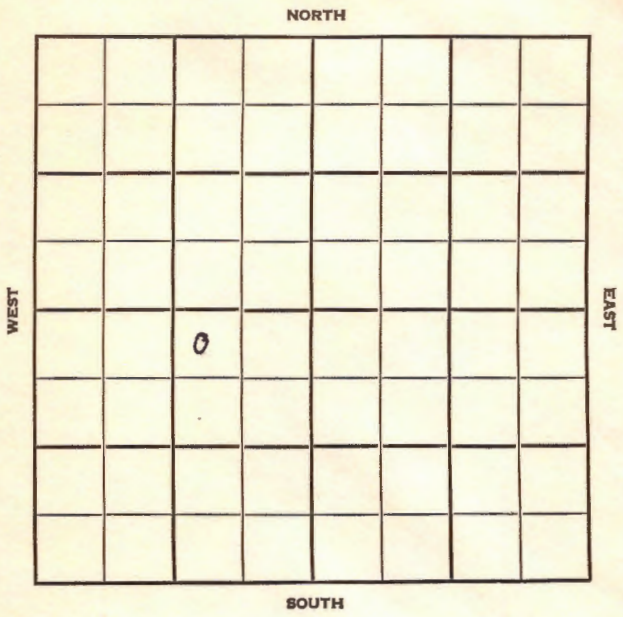

Reno KANSAS

SEC.	TWP.	R.
3	26	4W

WELL NO. #3 Prough FARM

COMPANY Phillips Pet

CONTRACTOR Stag Drlg.
Nicklaus


315' Ft. from N. Line

Ft. from S. Line

Ft. from E. Line

Ft. from W. Line

NW NE SW

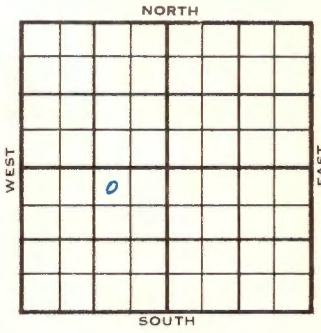

1955	ELEVATION 1548 REPORT
9/7	Comm 9-4-55 8" @ 340/250 Drlg 810
11/9	Comm 9-4-55 8" @ 340/250 5 1/2" @ 3358/35 H 2636 Tr 2648 Bl 2826 L 2865 BKC 3355 TD 3360 CO to 3321 36/3257-66 1 bo 8 gw 3 hr 500 A S/59 bo 69 Baw 2 hr S/44 bo 2 hr P/190 bo 25 bw 14 hr P/207 bo 25 bw 20 hr Comp 331 bopd 156 bw COMPLETED

DX-78

FORM 513 REV. SUNRAY

County Reno Elev.

Sec. 3 Twp. 26 Rge. 4W

Company Phillips Pet.

Farm Name Prough No. 3

TOPS	DEPTH	LOG	DATUM
Anh.			
Tp.			
H.			
Tr.			
Dg.			
Bl.			
L.			
K.C.			
B.K.C.			
Ce.			
C.			
M.			
M.			
K.			
Mz.			
Mo.			
V.			
S.			
S.			
A			
R.			
P€.			
G.			
T.D.			

Loc. in Sec. NW NE SW

315' NL

Geol.

Contr. Stag Drlg.

Pool Nicklaus

FIRST REPORT

0

SEP 7 '55

Date Comm. 9-4-55

8" @ 340/250 drlg. 810

Co. Lse. No. Sec. T. R.

FORM 513 REV. SUNRAY

County Reno Elev. 1548 Co.

Sec. 3 Twp. 26 Rge. 4W

Company Phillips Pet.

Farm Name Prough No. 3

TOPS	DEPTH	LOG	DATUM
Anh.			
Tp.			
H.	2636		1088
Tr.	2648		1100
Dg.			
Bl.	2826		1278
L.	2865		1317
K.C.			
B.K.C.	3355		1807
Ce.			
C.			
M.			
M.			
K.			
Mz.			
Mo.			
V.			
S.			
S.			
A			
R.			
P€.			
G.			
T.D.	3360		

Loc. in Sec. NW NE SW

315' NL

Geol.

Contr. Stag Drlg.

Lse.

Pool Nicklaus



No.

Date Comm. 9-4-55 NOV 9 1955

Sec.

8" @ 340/250 5½" @ 3358/35 CO to 3321

T.

36/ 3257-66 1 bo 8 gw 3 hr. 500 A

S/ 59 bo 69 baw 2 hr. S/ 44 bo 2 hr.

P/ 190 bo 25 bw 14 hr. P/ 207 bo

25 bw 20 hr. Comp. 331 bopd 156 bw

R.