

Sec. 4 Twp. 26 R. 4W

Well No. #2 Terry Farm

Harper Company
Miscellaneous


330 Ft. from N. Line

 Ft. from S. Line

990 Ft. from E. Line

 Ft. from W. Line

NW NE NE

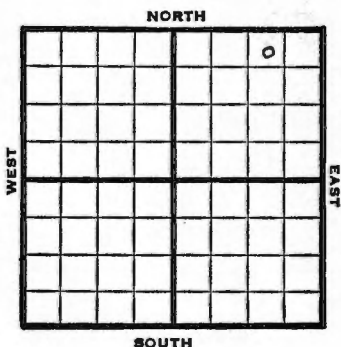

1947 Elev. 1539 REPORT

7/23	KUR
7/30	8" @ 320' Drlg 2735'
8/6	Drlg 3595'
8/13	Viola 4094 TD 4096 5" ● 4096'
8/20	"
8/27	1600' oil
9/3	"
9/10	"
9/17	"
9/24	"
10/1	Viola 4094 5" @ 4094 1000 acid Pump 319 oil & 16% W Pot TD 4096 Gravity 40

COMPLETED

Kansas

Map No. _____ Sec. 4 Twp. 26 R. 4W

Well No. 2 Terry

Harper

Company

FIRST REPORT

Contractor

NW NE NE

SECTION PLAT

330 Ft. from N. Line

_____ Ft. from S. Line

990 Ft. from E. Line

_____ Ft. from W. Line

			0

Reno County

Location _____

Rig up _____

Drilling and Remarks:

R U R

RECORD

Cased _____ in., _____ ft.

Sand _____

Gas _____

Oil _____

Total Depth _____

PRODUCTION

1st 24 hrs. Nat. _____

1st 24 hrs. after shot _____

Gas _____ Cu. Ft.

Dry Hole _____

Abandoned _____

Date

JUL 23 1947

19

S. J. LEWIS

Scout

Map No. 40 Sec. 4 Twp. 26 R. 4W

Well No. 2 Terry

Harper Company

COMPLETE

Contractor

NW NE NE

E. 1589

SECTION PLAT

330 Ft. from N. Line

_____ Ft. from S. Line

990 Ft. from E. Line

_____ Ft. from W. Line

			4

Beno County

Location _____

Rig up _____

Drilling and Remarks:

Vista 4894
5" @ 4094
1000 acid
Pump 319 oil +
16% W Bt
40 @ 9W

RECORD

Cased _____ in., _____ ft.

Sand _____

Gas _____

Oil _____

Total Depth 4096

PRODUCTION

1st 24 hrs. Nat. _____

1st 24 hrs. after shot _____

Gas _____ Cu. Ft.

Dry Hole _____

Abandoned _____

Date

OCT 1 1947 19

S. J. LEWIS Scout