


Section 8 Township 26 Range 4-W

Well Number #1-John Moore

Company Stanolind-Amerada

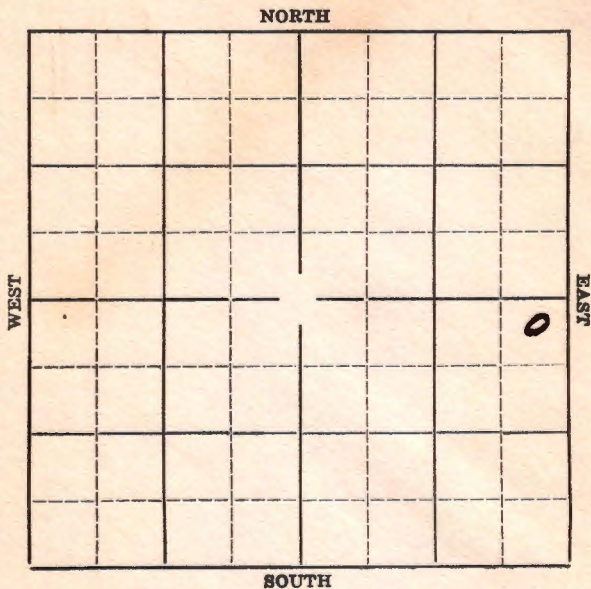


Sec. 8 Twp. 26 R. 4W

Well No. #1 John Moore Farm

Stanolind & Amerada Company

330' Ft. from N. Line
 _____ Ft. from S. Line
330' Ft. from E. Line
 _____ Ft. from W. Line

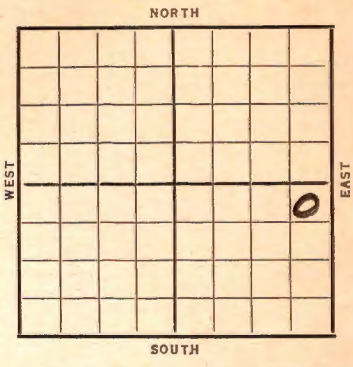

Elev. 1496

Date	REPORT
1936	
9/9	Building rig.
9/18	Rigging up.
9/24	13" @ 175'. Drlg. 1418'.
10/1	Topeka 2795'. Drlg. 2937'.
10/8	Chat 3604'. Drlg. 3615'.
10/15	Misener 4010'. Drlg. 4038'.
10/22	Viola 4035'. 7" @ 4034'. RUST.
10/29--	
11/6	T. D. 4041 Swabb 26 bbls. oil 7 bbls. water 6 hrs.
11/12	Shut down.
11/19--	
11/25	Viola 4035'. T. D. 4041'. P. B. 4039'.
	10 bbls. oil & 20 bbls. water.
	COMPLETED

KANSAS

Form 26-101 Eks.-2-29

Map No. 40 Sec. 5 Twp. 26 R. 4W

Well No. 1 John Moore


Contractor

SECTION PLAT

			0

330 Ft. from N. Line

_____ Ft. from S. Line

330 Ft. from E. Line

_____ Ft. from W. Line

FIRST REPORT

Location _____

Rig up _____

Drilling and Remarks:

Building rig

RECORD

Cased _____ in., _____ ft.

Sand _____

Gas _____

Oil _____

Total Depth _____

PRODUCTION

1st 24 hrs. Nat. _____

1st 24 hrs. after shot _____

Gas _____ Cu. Ft.

Dry Hole _____

Abandoned _____

Date ○

SEP 9 1936

S. J. LEWIS

Scout

Map No. 40 Sec. 8 Twp. 26 R. 4W.

Well No. John Moore


Contractor

SECTION PLAT

			○

380 Ft. from N. Line

_____ Ft. from S. Line

330 Ft. from E. Line

_____ Ft. from W. Line

COMPLETED

Location _____

Rig up _____

Drilling and Remarks:

Viola 4035
P.B 4039.
10 1/2 lb oil
20 1/2 lb water.

RECORD

Cased _____ in., _____ ft.

Sand _____

Gas _____

Oil _____

Total Depth 4041

PRODUCTION

1st 24 hrs. Nat. _____

1st 24 hrs. after shot _____

Gas _____ Cu. Ft.

Dry Hole _____

Abandoned _____

Date

NOV 25 1936 19

S. J. LEWIS

Scout