

KANSAS

Map No. _____ Sec. 9 Twp. 26 R. 4-W

Well No. 2--M.Harris Farm _____

Magnolia Company _____


_____ Ft. from N. Line

330 Ft. from S. Line

990 Ft. from E. Line

_____ Ft. from W. Line

Elev. 1522

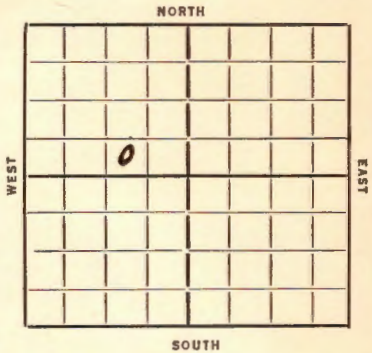

Date
1936

REPORT

4/1 Moving in

4/10 Rig.

4/16 Drlg. 200'

4/23 Drlg. 2264'

4/30 Drlg. 3237'.

5/7 --

5/14 Viola 4072'. set 7" RUST.

5/20/36- Viola 4072'.

T.D. 4075'.

Flow 626 bbls nat.

COMPLETED

KANSAS

Map No. 40 Sec. 9 Twp. 26 R. 4W

Well No. 2-M. Harris

Magnolia Company

Contractor

FIRST REPORTS

SECTION PLAT

..... Ft. from N. Line

330 Ft. from S. Line

990 Ft. from E. Line

..... Ft. from W. Line

	0		

Location.....

Rig up.....

Drilling and Remarks:

moving in

RECORD

Cased.....in.,ft.

Sand.....

Gas.....

Oil.....

Total Depth.....

PRODUCTION

1st 24 hrs. Nat.....

1st 24 hrs. after shot.....

Gas.....Cu. Ft.

Dry Hole.....

Abandoned.....

Date

4-1-36

192.....

ORVAL MANNSCHRECK

Scout

Map No. 40 Sec. 9 Twp. 26 R. 4 W

Well No. 2 Wayne Harris

Magnolia Pet. Company

Contractor

SECTION PLAT

_____ Ft. from N. Line

330 Ft. from S. Line

990 Ft. from E. Line

_____ Ft. from W. Line

COMPLETED

Location _____

Rig up _____

Drilling and Remarks:

Vista 4072.

Flow 626 Nat

RECORD

Cased _____ in., _____ ft.

Sand _____

Gas _____

Oil _____

Total Depth 4075

PRODUCTION

1st 24 hrs. Nat. _____

1st 24 hrs. after shot _____

Gas _____ Cu. Ft.

Dry Hole _____

Abandoned _____

Date

MAY 20 1936 19

S. J. LEWIS

Scout