


Section 9 Township 26 Range 4-W

Well Number 2-Harris

Company Magnolia

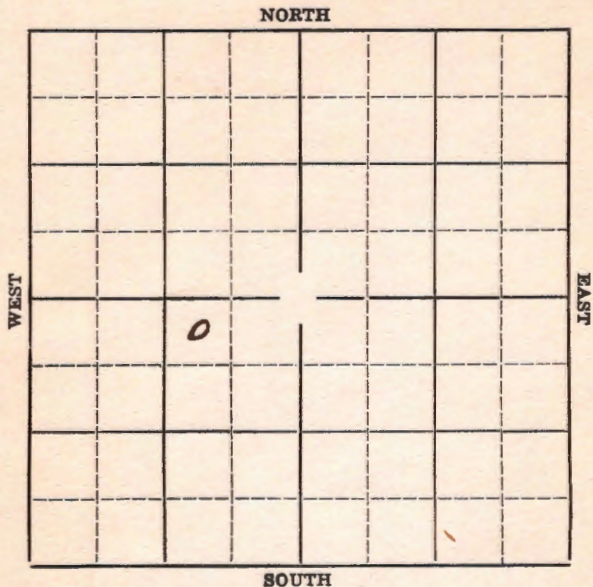

Map No. 40 Sec. 9 Twp. 26 R. 4 W

Well No. 2 Harris

Magnolia Company

Contractor

SECTION PLAT

330 Ft. from N. Line

..... Ft. from S. Line

990 Ft. from E. Line

..... Ft. from W. Line

	0		

FIRST REPORT

Location.....

Rig up.....

Drilling and Remarks:

Rig

RECORD

Cased.....in.,ft.

Sand.....

Gas.....

Oil.....

Total Depth.....

PRODUCTION

1st 24 hrs. Nat.....

1st 24 hrs. after shot.....

Gas.....Cu. Ft.

Dry Hole.....

Abandoned.....

Date

APR 29 1936

192

S. J. LEWIS

Scout

Map No. 40 Sec. 9 Twp. 26 R. 4W

Well No. 2 C Harris

Magnolia Company
Contractor

SECTION PLAT

330 Ft. from N. Line
_____ Ft. from S. Line
990 Ft. from E. Line
_____ Ft. from W. Line

	0		

COMPLETED

Location _____

Rig up _____

Drilling and Remarks:

Viola 4065
1000 acid
Pump 11586

RECORD

Cased _____ in., _____ ft.

Sand _____

Gas _____

Oil _____

Total Depth 4068

PRODUCTION

1st 24 hrs. Nat. _____

1st 24 hrs. after shot _____

Gas _____ Cu. Ft.

Dry Hole _____

Abandoned _____

Date

JUN 24 1936 19

S. J. LEWIS

Scout