


Section 9 Township 26 Range 4-W

Well Number 4 M. Harris

Company Magnolia

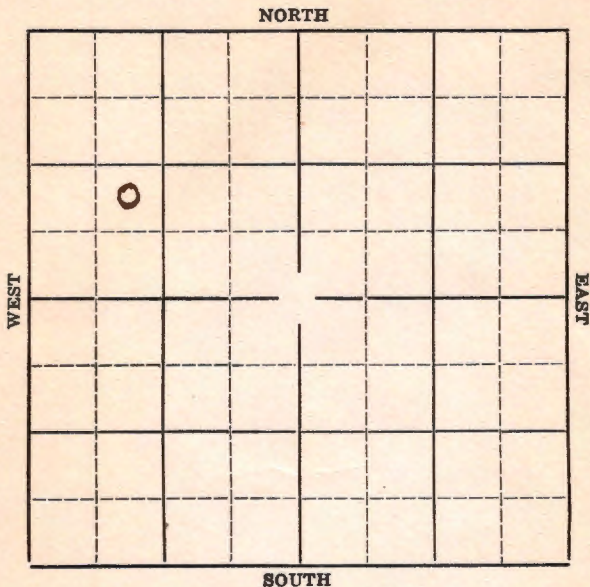

Sec. 9 Twp. 26 R. 4-W

Well No. #4 M. Harris Farm

Magnolia Company


_____ Ft. from N. Line

990 Ft. from S. Line

_____ Ft. from E. Line

990 Ft. from W. Line

Elev. 1519

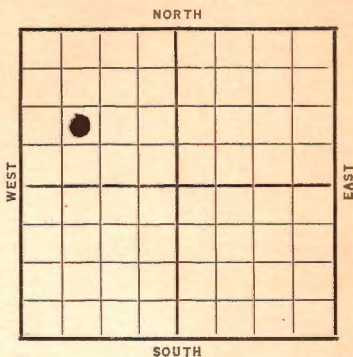

Date
1937

REPORT

2/24

Rig

2/26

12" @ 200 WOC.

3/4

Drlg. 2300'.

3/11

Drlg. 3520'

3/18

Misener 4034'. 7" @ 4059' RUST

3/25

" " " "

4/2

" " " " "

4/7

Viola 4055'.

T. D. 4058'.

250 acid.

Potential 1192.

COMPLETED

Map No. 40 Sec. 9 Twp. 26 R. 4W.

Well No. 4 M. Harris

Magnolia Company

Contractor

SECTION PLAT

o			

_____ Ft. from N. Line

990 Ft. from S. Line

_____ Ft. from E. Line

990 Ft. from W. Line

FIRST REPORT

Location _____

Rig up _____

Drilling and Remarks:

Rig

RECORD

Cased _____ in., _____ ft.

Sand _____

Gas _____

Oil _____

Total Depth _____

PRODUCTION

1st 24 hrs. Nat. _____

1st 24 hrs. after shot _____

Gas _____ Cu. Ft.

Dry Hole _____

Abandoned _____

Date

FEB 24 1937 19

S. J. LEWIS Scout

KANSAS *Perm.*

Map No. 40 Sec. 9 Twp. 26 R. 4W

Well No. 4 Amos Harris

Magnolia Company
Contractor

SECTION PLAT

o			

_____ Ft. from N. Line
990 Ft. from S. Line
_____ Ft. from E. Line
990 Ft. from W. Line

COMPLETED

Location _____

Rig up _____

Drilling and Remarks:

Viola 4058
250 acid
Potential
1192.

RECORD

Cased _____ in., _____ ft.
Sand _____
Gas _____
Oil _____
Total Depth 4058

PRODUCTION

1st 24 hrs. Nat. _____
1st 24 hrs. after shot _____
Gas _____ Cu. Ft.
Dry Hole _____
Abandoned _____

Date

APR 7 1937 19

S. J. LEWIS

Scout