




Keno

Map No. **KANSAS** Sec. 9 Twp. 26 R. 4W

Well No. 1- Holtje Farm \_\_\_\_\_  
Empire Oil Co Company \_\_\_\_\_

330 Ft. from N. Line  
\_\_\_\_\_ Ft. from S. Line  
\_\_\_\_\_ Ft. from E. Line  
330 Ft. from W. Line

Elev. 1553

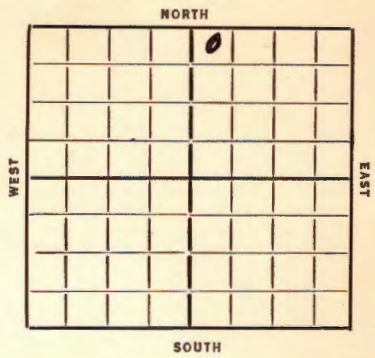

REPORT

~~1936~~

3/11 A. R.

3/13 --

3/20 Rign.

3/27 15"-165' Drlg. 860'

4/2 Drlg. 2070'

4/10 Drlg. 3054'

4/16 Drlg. 3535'

4/23 Chat 3667' Base L. 3989' Drlg.  
3990'

4/30 4086' RUST.

5/7 Viola 4115-18'. 500' oil in 17 hrs.  
Cleaning out.

5/14 T.D. 4220'. 500 acid.

5/20/36- Viola 4115'.

T.D. 4120'

14 bbls oil 800 bbls water.

D & A

**ABANDONED**

Map No. 40 Sec. 9 Twp. 26 R. 4W

Well No. 1-Holtz

Empire O. & G. Company

Contractor

FIRST REPORTS

330 Ft. from N. Line

..... Ft. from S. Line

..... Ft. from E. Line

330 Ft. from W. Line

SECTION PLAT

		○	

Location.....

Rig up.....

Drilling and Remarks:

*B.R.*

RECORD

Cased..... in., ..... ft.

Sand.....

Gas.....

Oil.....

Total Depth.....

PRODUCTION

1st 24 hrs. Nat.....

1st 24 hrs. after shot.....

Gas..... Cu. Ft.

Dry Hole.....

Abandoned.....

Date

3-11-36

192.....

ORVAL MANNSCHRECK

Scout

Map No. 10 Sec. 9 Twp. 26 R. 4W

Well No. 1 Holtz's

Empire

Company

Contractor

SECTION PLAT

		0	

330 Ft. from N. Line

\_\_\_\_\_ Ft. from S. Line

\_\_\_\_\_ Ft. from E. Line

330 Ft. from W. Line

ABANDONED

Location \_\_\_\_\_

Rig up \_\_\_\_\_

Drilling and Remarks:

*Viola 4115-*  
*1488 coil*  
*800 8 1/2 water*  
*J. A.*

RECORD

Cased \_\_\_\_\_ in., \_\_\_\_\_ ft.

Sand \_\_\_\_\_

Gas \_\_\_\_\_

Oil \_\_\_\_\_

Total Depth 4120

PRODUCTION

1st 24 hrs. Nat. \_\_\_\_\_

1st 24 hrs. after shot \_\_\_\_\_

Gas \_\_\_\_\_ Cu. Ft.

Dry Hole \_\_\_\_\_

Abandoned \_\_\_\_\_

Date

MAY 20 1936

19

S. J. LEWIS

Scout