


Section 9 Township 26 Range 4-W

Well Number #4 C. Harris

Company Magnolia

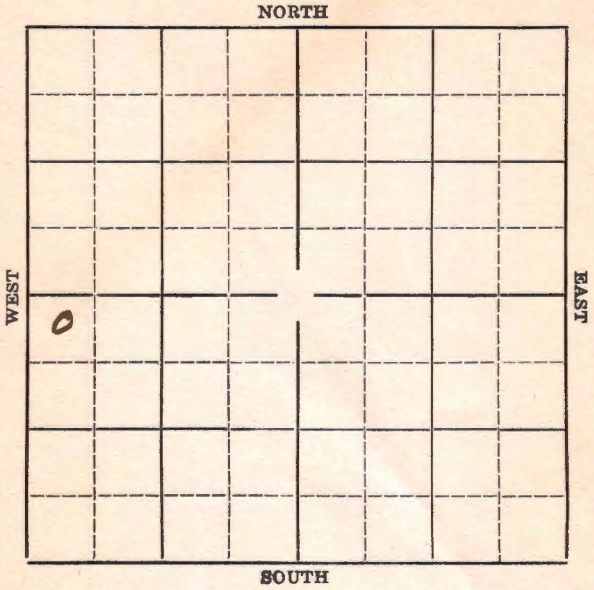

Sec. 9 Twp. 26 R. 4W

Well No. #4 C Harris Farm


Magnolia Company

330' Ft. from N. Line

\_\_\_\_\_ Ft. from S. Line

\_\_\_\_\_ Ft. from E. Line

330' Ft. from W. Line

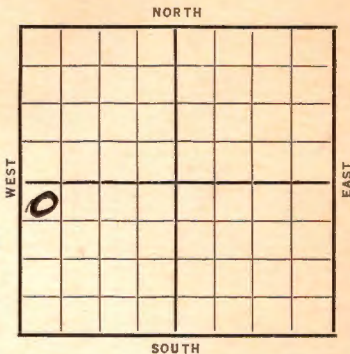

Elev. 1497

~~1936~~ 1936

REPORT

9/30 Cellar.

10/8 Rigging up.

10/15 12" @ 201'. Drlg. 850'.

10/22 Drlg. 3070'.

10/29 **Caht 3610'**. Drlg. 3765'.

~~11/6~~ 7" @ 4028 Rust

11/12 **Viola 4040** T. D. 4042

200' oil. 250 acid.

11/18 **Viola 4040** T. D. 4042

250 acid. Pot. 868.

**COMPLETED**

Map No. 40 Sec. 9 Twp. 26 R. 4W

Well No. 4 @ Harris

Magnolia Company

Contractor

SECTION PLAT

<u>0</u>			

330 Ft. from N. Line

\_\_\_\_\_ Ft. from S. Line

\_\_\_\_\_ Ft. from E. Line

330 Ft. from W. Line

FIRST REPORT

Location \_\_\_\_\_

Rig up \_\_\_\_\_

Drilling and Remarks:

@ Harris

RECORD

Cased \_\_\_\_\_ in., \_\_\_\_\_ ft.

Sand \_\_\_\_\_

Gas \_\_\_\_\_

Oil \_\_\_\_\_

Total Depth \_\_\_\_\_

PRODUCTION

1st 24 hrs. Nat. \_\_\_\_\_

1st 24 hrs. after shot \_\_\_\_\_

Gas \_\_\_\_\_ Cu. Ft.

Dry Hole \_\_\_\_\_

Abandoned \_\_\_\_\_

Date

SEP 30 1936 19

S. J. LEWIS

Scout

Map No. 40 Sec. 9 Twp. 26 R. 4W

Well No. 4 @ Harris

Magnolia Company

Contractor

**SECTION PLAT**

230 Ft. from N. Line

\_\_\_\_\_ Ft. from S. Line

\_\_\_\_\_ Ft. from E. Line

230 Ft. from W. Line

0			

COMPLETED

Location \_\_\_\_\_

Rig up \_\_\_\_\_

Drilling and Remarks:

*Vista 4040  
250 acid  
P 8768*

**RECORD**

Cased \_\_\_\_\_ in., \_\_\_\_\_ ft.

Sand \_\_\_\_\_

Gas \_\_\_\_\_

Oil \_\_\_\_\_

Total Depth 4042

**PRODUCTION**

1st 24 hrs. Nat. \_\_\_\_\_

1st 24 hrs. after shot \_\_\_\_\_

Gas \_\_\_\_\_ Cu. Ft.

Dry Hole \_\_\_\_\_

Abandoned \_\_\_\_\_

Date

NOV 18 1936 19

S. J. LEWIS Scout