


Section 9 Township 26 Range 4-W

Well Number #1 Ladd

Company Stanolind et al

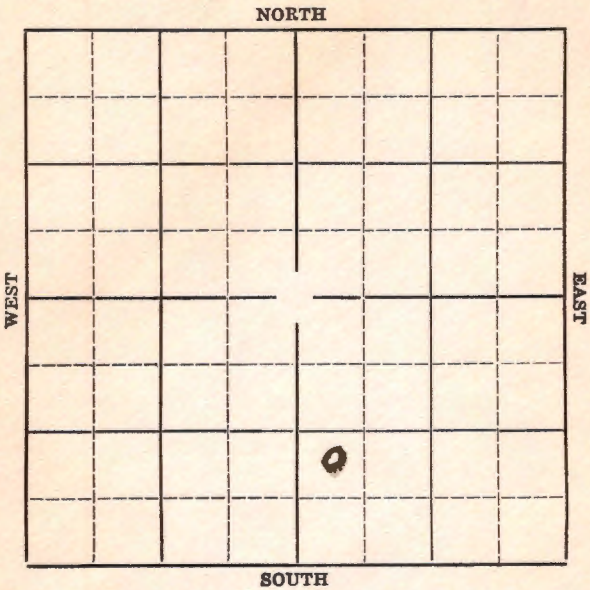


Sec. 9 Twp. 26 R. 4W

Well No. #1 Ladd Farm

Stanolind et al Company

NORTH

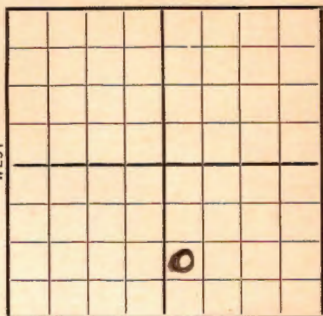

SOUTH

\_\_\_\_\_ Ft. from N. Line

990'

\_\_\_\_\_ Ft. from S. Line

\_\_\_\_\_ Ft. from E. Line

330'

\_\_\_\_\_ Ft. from W. Line

Elev. 1520

19 <u>36</u>	REPORT
10/21	Location.
10/29	-- 11/6--11/12--
11/19	Rig
11/27	Rigging up
12/3	13" @ 153'. Drlg. 2071'.
12/10	Drlg. 3278'.
12/17	<u>Chat 3643'</u> Drlg.
12/29	<u>Viola 4086'</u> . T. D. 4089'.
	water. Abandoned.
	<b>ABANDONED</b>

Map No. 40 Sec. 9 Twp. 26 R. 4W

Well No. 1 Ladd

Standard Oil Company

Contractor

SECTION PLAT

		0	

\_\_\_\_\_ Ft. from N. Line

990 Ft. from S. Line

\_\_\_\_\_ Ft. from E. Line

330 Ft. from W. Line

FIRST REPORT

Location ✓

Rig up \_\_\_\_\_

Drilling and Remarks:

RECORD

Cased \_\_\_\_\_ in., \_\_\_\_\_ ft.

Sand \_\_\_\_\_

Gas \_\_\_\_\_

Oil \_\_\_\_\_

Total Depth \_\_\_\_\_

PRODUCTION

1st 24 hrs. Nat. \_\_\_\_\_

1st 24 hrs. after shot \_\_\_\_\_

Gas \_\_\_\_\_ Cu. Ft.

Dry Hole \_\_\_\_\_

Abandoned \_\_\_\_\_

Date

OCT 21 1930

S. J. LEWIS

Scout

Map No. \_\_\_\_\_ Sec. 9 Twp. 26 R. 4W

Well No. 1 Ladd

Standard & Co Company

Contractor

**SECTION PLAT**

		o	

\_\_\_\_\_ Ft. from N. Line

990 Ft. from S. Line

\_\_\_\_\_ Ft. from E. Line

330 Ft. from W. Line

ABANDONED

Location \_\_\_\_\_

Rig up \_\_\_\_\_

Drilling and Remarks:

Vista 4086  
water

JH

**RECORD**

Cased \_\_\_\_\_ in., \_\_\_\_\_ ft.

Sand \_\_\_\_\_

Gas \_\_\_\_\_

Oil \_\_\_\_\_

Total Depth 4089

**PRODUCTION**

1st 24 hrs. Nat. \_\_\_\_\_

1st 24 hrs. after shot \_\_\_\_\_

Gas \_\_\_\_\_ Cu. Ft.

Dry Hole \_\_\_\_\_

Abandoned \_\_\_\_\_

Date

DEC 29 1936 19

S. J. LEWIS

Scout