

Reno
40

KANSAS

Map No. _____ Sec. 9 Twp. 26 R. _____

Well No. _____ Farm _____

Rodgers
Magnolia


Company _____

_____ Ft. from N. Line

330 Ft. from S. Line

990 Ft. from E. Line

_____ Ft. from W. Line

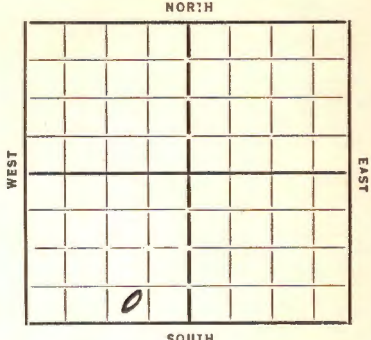

Elev. 1503

REPORT

Date 9/35

9/4 Allan

10/3 dely 3250

10/10 WOC 5614

11/1 dely 3892

11/7 BML 3920

Meisner 4005-07

dely 4008

11/4 Viola 4040 7" 4040 WOC

11/16 Viola 4040

TD 4041 1/2

slowed 16 Bbls per hr (1 1/2 hrs)

11/21 dely tanks TD 4042

11/29 swabber 201 Bbls 4 hrs

SD for PL

12/4 Viola 4040

TD 4042

948 Bbls.

COMPLETED

KANSAS

Map No. 40 Sec. 9 Twp. 26 R. 4W

Well No. 1-Rodgers

Magnolia Company

Contractor

COMPLETE

SECTION PLAT

..... Ft. from N. Line

330 Ft. from S. Line

990 Ft. from E. Line

..... Ft. from W. Line

	0		

Location.....

Rig up.....

Drilling and Remarks:

948 lbs

RECORD

Cased..... in., ft.

Sand Viola 4040

Gas.....

Oil.....

Total Depth 4042

PRODUCTION

1st 24 hrs. Nat.....

1st 24 hrs. after shot.....

Gas..... Cu. Ft.

Dry Hole.....

Abandoned.....

Date

12-4-35 192.....

ORVAL MANNSCHECK

Scout

Map No. 40 Sec. 9 Twp. 26 R. 4^W

Well No. 1-A Rodgers

Magnolia Company

Contractor

FIRST REPORTS

SECTION PLAT

..... Ft. from N. Line

330 Ft. from S. Line

990 Ft. from E. Line

..... Ft. from W. Line

	0		

Location.....

Rig up.....

Drilling and Remarks:

clean

RECORD

Cased..... in., ft.

Sand.....

Gas.....

Oil.....

Total Depth.....

PRODUCTION

1st 24 hrs. Nat.....

1st 24 hrs. after shot.....

Gas..... Cu. Ft.

Dry Hole.....

Abandoned.....

Date

9-4-35 192.....

ORVAL MANSCHRECK Scout