


Section 9 Township 26 Range 4-W

Well Number #3-Rodgers

Company Magnolia

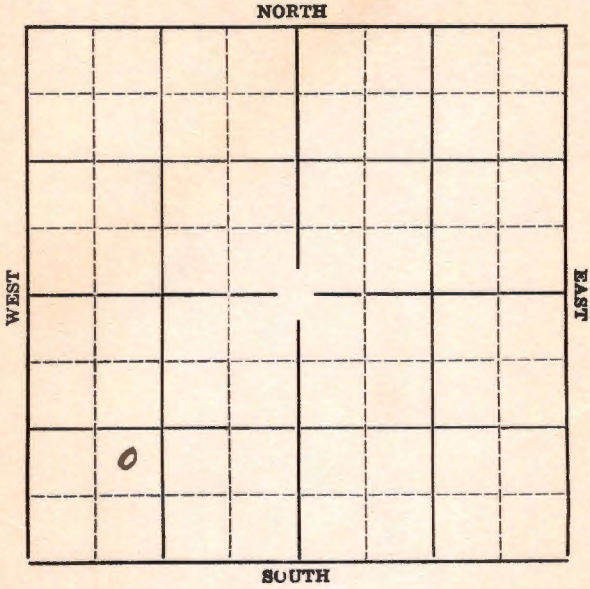

Map No. **KANSAS** Sec. **9** Twp. **26** R. **4W**

Well No. **#3 Rodgers** Farm
Magnolia Company


_____ Ft. from N. Line

990' Ft. from S. Line

_____ Ft. from E. Line

990' Ft. from W. Line

Elev. 1498

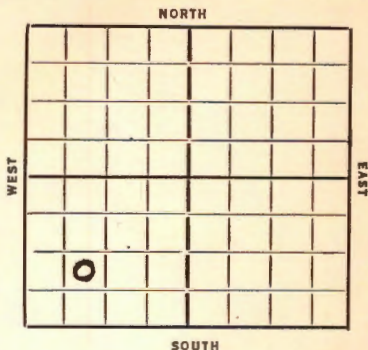

1936

REPORT

7/1 Rigging up.

7/9 Drlg 1350'.

7/16 Drlg. 3250'.

7/23 **Chat 3614'. Misner 4404-05'. TD**
4237'. Set 7".

7/30 Clean out.

8/6 **Viola 4042'. T.D. 4050(.** Swab 40
bbls of oil per hour.

8/12/36-**Viola 4042'.**

T.D. 4050'.

Potential 817 bbls of oil nat.

COMPLETED

KANSAS

Map No. 40 Sec. 9 Twp. 26 R. 4W

Well No. 3 Rodgers

Magnolia Company

Contractor

SECTION PLAT

_____ Ft. from N. Line

990 Ft. from S. Line

_____ Ft. from E. Line

990 Ft. from W. Line

FIRST REPORT

Location _____

Rig up _____

Drilling and Remarks:

Rigging up

RECORD

Cased _____ in., _____ ft.

Sand _____

Gas _____

Oil _____

Total Depth _____

PRODUCTION

1st 24 hrs. Nat. _____

1st 24 hrs. after shot _____

Gas _____ Cu. Ft.

Dry Hole _____

Abandoned _____

Date

JUL 1 1936 19

S. J. LEWIS Scout

