


Section.....9.....Township.....26.....Range 4-W.....

Well Number.....4 Rodgers.....

Company.....Magnolia.....

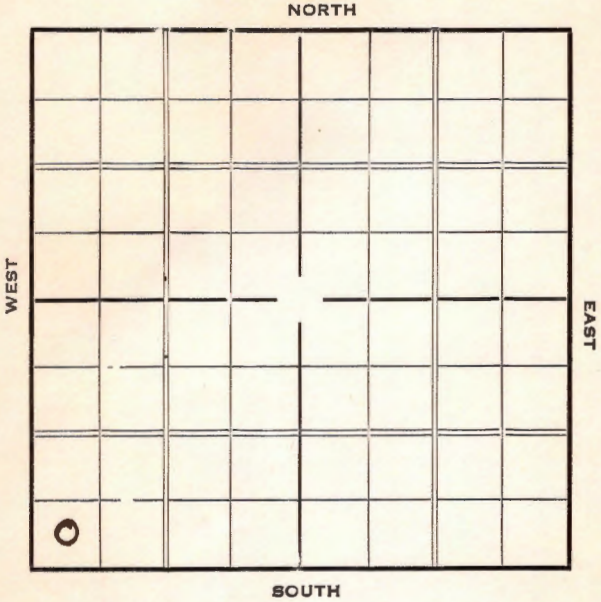

Sec. 9 Twp. 26 R. 4-W

Well No. #4 Rodgers Farm

Magnolia Company


 Ft. from N. Line

330 Ft. from S. Line

 Ft. from E. Line

330 Ft. from W. Line

Elev. 1490

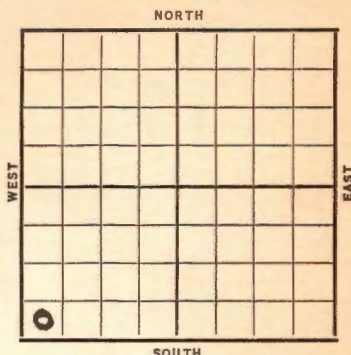

Date	REPORT
1937	
4/14	Location
4/23	13" @ 192'. WOC.
4/30	Drlg. 2800'.
5/7	Chat 3616' . Drlg. 3710'.
5/14	7" @ 4012' T.D. RUST.
5/19	7" @ 4012'.
	Viola 4017' .
	T.D. 4022'.
	Flowed 15 bbls. per hour
	natural.
	250 acid.
	Pot., Pumped 884 bbls. 24 hrs.
	COMPLETED

Reno

KANSAS

Map No. 40 Sec. 9 Twp. 26 R. 4 W

Well No. 4-Rodgers

Magnolia Company

Contractor

COMPLETED

SECTION PLAT

 Ft. from N. Line
330 Ft. from S. Line
 Ft. from E. Line
330 Ft. from W. Line

0			

Location _____

RECORD

Rig up _____

Cased 7 in., 4012 ft.

Drilling and Remarks:

Sand Viola 4017

flowed 15 bbls per hr. natural
250 acid
Pot - pumped
884/24 hrs

Gas _____

Oil _____

Total Depth 4022

PRODUCTION

1st 24 hrs. Nat. _____

1st 24 hrs. after shot _____

Gas _____ Cu. Ft.

Dry Hole _____

Abandoned _____

Date

MAY 19 1937 19

H. D. Hatfield Scout

KANSAS *Read*

Map No. _____ Sec. 9 Twp. 26 R. 4W

Well No. 4 Rodgers

Magnolia Company

Contractor

SECTION PLAT

_____ Ft. from N. Line

330 Ft. from S. Line

_____ Ft. from E. Line

330 Ft. from W. Line

FIRST REPORT

Location ✓

Rig up _____

Drilling and Remarks:

RECORD

Cased _____ in., _____ ft.

Sand _____

Gas _____

Oil _____

Total Depth _____

PRODUCTION

1st 24 hrs. Nat. _____

1st 24 hrs. after shot _____

Gas _____ Cu. Ft.

Dry Hole _____

Abandoned _____

Date

APR 1 ± 1937 ₁₉

S. J. LEWIS Scout