

Map No. KANSAS Sec. 9 Twp. 26 R. 4W


Well No. 1 - Harjes Magnolia Farm _____ Company _____

Revo

NORTH

WEST

EAST

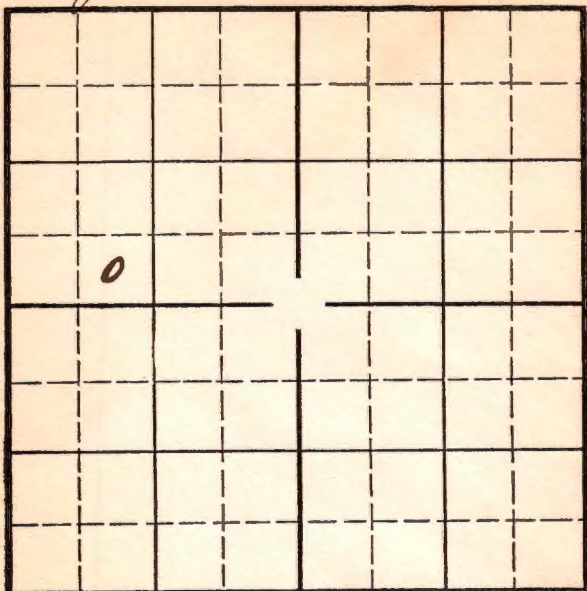

SOUTH

Location _____
Drilling Remarks _____

Rig Up _____
Drilling Remarks _____

RECORD

Cased _____ in. _____ ft.
 Sand _____
 Gas _____
 Oil _____
 Total Depth _____

PRODUCTION

1st 24 hrs. Nat. _____
 1st 24 hrs. after shot _____
 Gas _____ cu. ft. _____
 Dry Hole _____
 Abandoned _____

Map No. _____ Sec. 9 Twp. 26 R. 4W

Well No. J Harris Farm _____
Magnolia Company _____


_____ Ft. from N. Line

330 Ft. from S. Line

_____ Ft. from E. Line

990 Ft. from W. Line

Elevation 1511

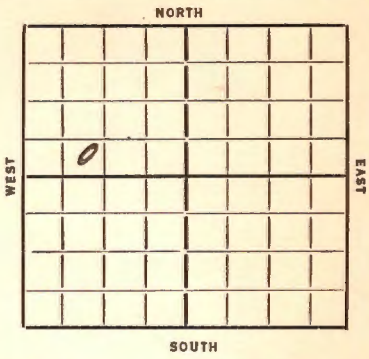

Date	REPORT
1935	
11/27	Location
12/6	RR
12/13	12" 195
12/19	Sly 2252
12/26	" 3148
12/36	" 3803 T. Chet 3607
1/10	Base Misc 3940
	Top Wisener 4021
	7" 4028 WOC
1/17	Top Viola 4052
	TD 4053 soil
	Ring liner
1/22	Viola 4052
	TD 4055
	415 bbl.

COMPLETED

KANSAS

Map No. 40 Sec. 9 Twp. 26 R. 4W

Well No. 1-Harris

Magnolia Company

Contractor

FIRST REPORTS

SECTION PLAT

..... Ft. from N. Line

330 Ft. from S. Line

..... Ft. from E. Line

990 Ft. from W. Line

0			

Location

Rig up

Drilling and Remarks:

RECORD

Cased..... in., ft.

Sand.....

Gas.....

Oil.....

Total Depth.....

PRODUCTION

1st 24 hrs. Nat.....

1st 24 hrs. after shot.....

Gas..... Cu. Ft.

Dry Hole.....

Abandoned.....

Date

11-27-35 192.....

ORVAL MANNSCHRECK

Scout

Map No. 40 Sec. 9 Twp. 26 R. 4W

Well No. 1 - Harris

Magnolia Company

Contractor

SECTION PLAT

..... Ft. from N. Line

330 Ft. from S. Line

..... Ft. from E. Line

940 Ft. from W. Line

0			

COMPLETED

Location.....

Rig up.....

Drilling and Remarks:

415 bbls

RECORD

Cased..... in., ft.

Sand Viola 4052

Gas.....

Oil.....

Total Depth 4055

PRODUCTION

1st 24 hrs. Nat.....

1st 24 hrs. after shot.....

Gas..... Cu. Ft.

Dry Hole.....

Abandoned.....

Date

JAN 22 1936

192

Scout

ORVAL MANNSCHECK