


Section.....8.....Township.....26.....Range.....4-W.....

Well Number.....#3 Moore.....

Company.....Stanolind-Amerada.....

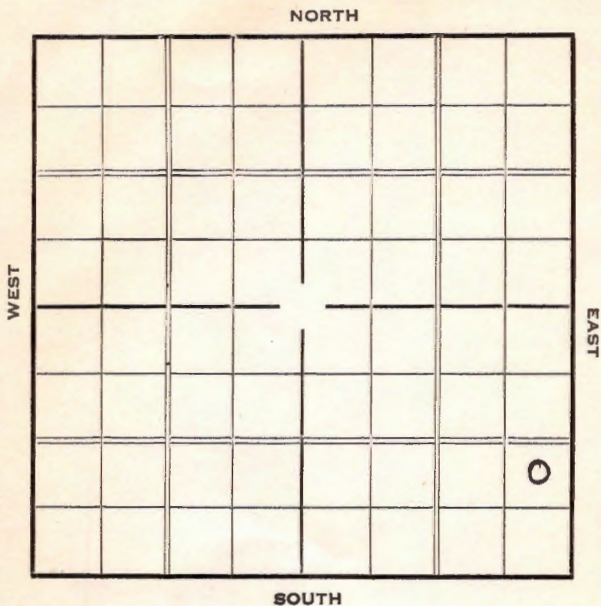

Sec. 8 Twp. 26 R. 4-7

Well No. #3 Moore Farm


Stanolind-Amerada Company

 Ft. from N. Line

990 Ft. from S. Line

330 Ft. from E. Line

 Ft. from W. Line

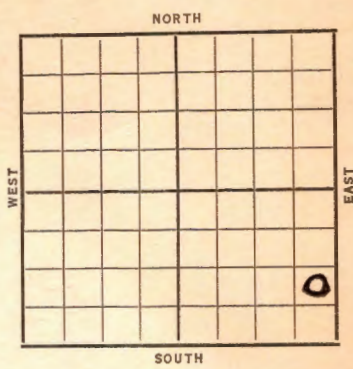

Date	REPORT
1937	
7/21	Location
7/30	Cellar
8/6	12" @ 173'. WOC.
8/13	Drlg. 2693'.
8/20	Drlg. 3671'.
8/28	Chat 3612'. 6" @ 4012'. WOC.
9/3	Misner 4001'. RUST.
9/10	" " " "
9/17	Viola 4021'. 600' oil @ 4023'.
	1200' oil @ 4024'.
	Swabbed 1 B.O.P.H.
	300 acid.
9/22	Viola 4021'.
	T.D. 4024'.
	300 acid.
	Pump & flow 1574 bbls.
	Cut 1%.
	ABANDONED

Reno

Map No. 40 Sec. 8 Twp. 26 R. 4W

Well No. 3-Moore

Standard-Amerasia Company

Contractor

FIRST REPORT

SECTION PLAT

_____ Ft. from N. Line
990 Ft. from S. Line
330 Ft. from E. Line
 _____ Ft. from W. Line

			0

Location ✓

Rig up _____

Drilling and Remarks:

RECORD

Cased _____ in., _____ ft.
 Sand _____
 Gas _____
 Oil _____
 Total Depth _____

PRODUCTION

1st 24 hrs. Nat. _____
 1st 24 hrs. after shot _____
 Gas _____ Cu. Ft.
 Dry Hole _____
 Abandoned _____

Date

JUL 21 1937 19

H. D. Hatfield Scout

KANSAS

Map No. 410 Sec. 8 Twp. 26 R. 4W

Well No. 3-J. F. Moore

Stano-Amerada Company

Contractor

SECTION PLAT

			0

_____ Ft. from N. Line

990 Ft. from S. Line

330 Ft. from E. Line

_____ Ft. from W. Line

COMPLETED

Location _____

Rig up _____

Drilling and Remarks:

300 and

Pump + flow

1574 bbls

cut 10%

RECORD

Cased _____ in., _____ ft.

Sand Viola 4021

Gas _____

Oil _____

Total Depth 4024

PRODUCTION

1st 24 hrs. Nat. _____

1st 24 hrs. after shot _____

Gas _____ Cu. Ft.

Dry Hole _____

Abandoned _____

Date

SEP 22 1937

19

H. D. Hatfield

Scout