


Section 8 Township 26 Range 4-W

Well No. 4 - Moore

Company Stanolind & Amerada

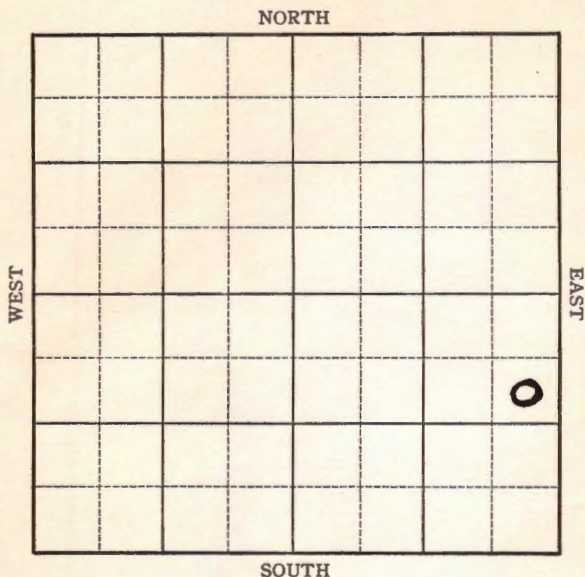

Sec. 8 Twp. 26 R. 4-W

Well No. #4 Moore Farm


Stanolind & Amerada Company

990 Ft. from N. Line

_____ Ft. from S. Line

330 Ft. from E. Line

_____ Ft. from W. Line

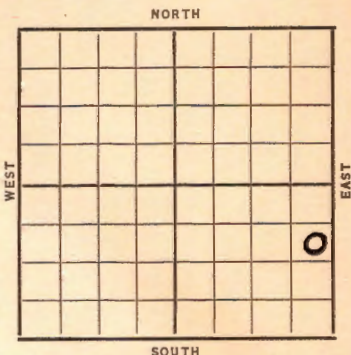

Elev. 1493

Date	REPORT
1937	
8/4	Cellar
8/13	"
8/20	"
8/28	R. R.
9/3	12" @ 172'. Drlg. 3065'.
9/10	Drlg. 2585'.
9/17	Drlg. 3481'.
9/24	Drlg. 3885'.
10/2	Misner 3999'. 7" @ 4010' T.D.
	RUST. No shows.
10/8	" " "
10/15	Viola 4026'. T.D. 4028'.
	1½ bailer oil 2 hrs.
	OVER

Reno **KANSAS**

Map No. 40 Sec. 8 Twp. 26 R. 4w

Well No. 4-Moore

Stanford & Amerada Company

Contractor

FIRST REPORT

SECTION PLAT

990 Ft. from N. Line

_____ Ft. from S. Line

330 Ft. from E. Line

_____ Ft. from W. Line

			0

Location _____

Rig up _____

Drilling and Remarks:

Cellar

RECORD

Cased _____ in., _____ ft.

Sand _____

Gas _____

Oil _____

Total Depth _____

PRODUCTION

1st 24 hrs. Nat. _____

1st 24 hrs. after shot _____

Gas _____ Cu. Ft.

Dry Hole _____

Abandoned _____

Date

AUG 4 - 1937 19

H. D. Hatfield Scout

Map No. 40 Sec. 8 Twp. 26 R. 4WWell No. 4 MooreStanolind-Amerada Company

Contractor

COMPLETED

SE NE SE

990 Ft. from N. Line

_____ Ft. from S. Line

330 Ft. from E. Line

_____ Ft. from W. Line

SECTION PLAT

			0

Location _____

Rig up _____

Drilling and Remarks:

250 AcidPOT-1184

RECORD

Cased 7 in., 4010 ft.Sand Misner 3999Gas Viola 4026

Oil _____

Total Depth 4028

PRODUCTION

1st 24 hrs. Nat. _____

1st 24 hrs. after shot _____

Gas _____ Cu. Ft.

Dry Hole _____

Abandoned _____

Date

OCT 20 1937 19H. D. Hatfield Scout