

A 10x10 grid with the following labels:

- WEST (left side)
- EAST (right side)
- SOUTH (bottom side)

A circled '0' is located in the 5th column from the left and the 5th row from the bottom.

Sec. 4 Twp. 26 R. 35W ✓

Well No. #1 Gilart Farm

Magnolia Company


Hugoton Pool (Barnett, Cont.)

 Ft. from N. Line

330' Ft. from S. Line

 Ft. from E. Line

330' Ft. from W. Line

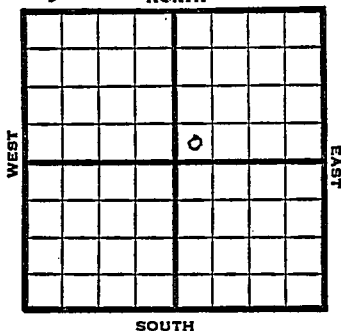

SW NE

1949

Elev 3001'

R E P O R T

6/8 Drlg. 820'
6/15 10" @ 845'
Drlg. 2600'
6/21 TD 2775'
6" @ 2774'
144 shots 2677-2704 - 7000 acid
6/28 384 shots 2514-2658 - 28,000 acid
7/6 48 shots 2486-95
7000 acid
7/13 TD 2775'
6" @ 2774'
Perf
42000 acid
31,080,000 Gas
283# R Pr.
Comp

COMPLETED

Kearny County Kansas State

Map No. _____ Sec. 4 Twp. 26 R. 35W

Well No. 1 Gilart

Magnolia Company

Barnett Contractor

SW NE


FIRST REPORT SECTION PLAT

_____ Ft. from N. Line

330 Ft. from S. Line

_____ Ft. from E. Line

330 Ft. from W. Line

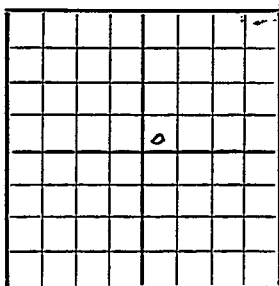

Hugoton Pool

Remarks:

drlg. 820

Date JUN 8 1949

Scout S. J. LEWIS

Map No. ✓ Sec. 4 Twp. 26 R. 35W

Well No. 1 Gilart

Magnolia


Company

COMPLETE

Contractor

SW NE

E. 1.3001
SECTION PLAT

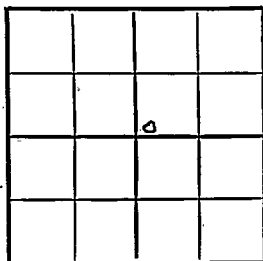

 Ft. from N. Line

330 Ft. from S. Line

 Ft. from E. Line

330 Ft. from W. Line

Kearny County

RECORD

Location

Cased in., ft.

Rig up

Sand

Drilling and Remarks:

Gas

6" 62774

Oil

Total Depth 2225

Perf.

420000000

31,050,000 Cu

253 R Pe*

PRODUCTION

1st 24 hrs. Nat.

1st 24 hrs. after shot

Gas Cu. Ft.

Dry Hole

Abandoned

Date

JUL 13 1949

19

S. J. LEWIS

Scout