


KANSAS

Kearny County

FORM 51 IOM 12-46 PETROL

Section 4 Township 26 Range 36WWell No. 8 Masonic HomeCompany Fin-Ker

Hugoton Pool

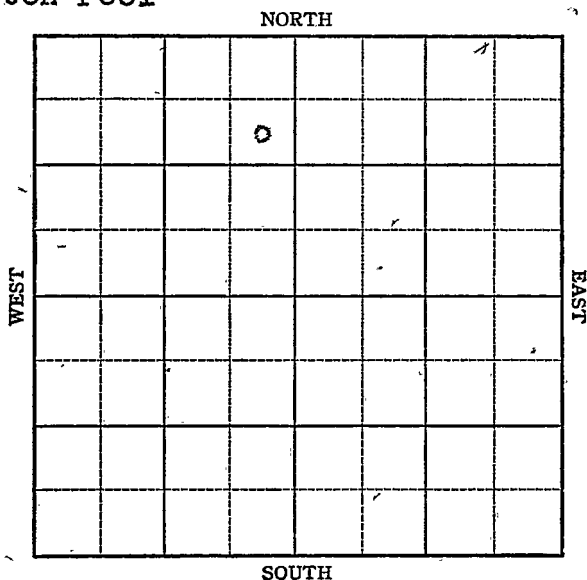

Sec. 4 Twp. 26 R. 36-W

Well No. #8 Masonic Home Farm

Fin-Ker Company

Hugoton Pool


990 Ft. from N. Line

 Ft. from S. Line

330 Ft. from E. Line

 Ft. from W. Line

SE NE NW

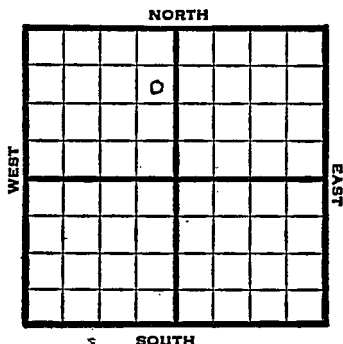

1947 Elev. 3044.7 REPORT

7/9	16" @ 102' Drlg 250'
7/16	Fishing 1600'
7/22	10" @ 1594 Drlg. 2300
7/29	TD 2680' 7" @ 2674' RUST
8/6	"
8/13	"
8/20	"
8/27	"
9/3	"
9/10	"
9/17	"
9/24	"
10/1	"
10/8	"
10/15	"

OVER

1947

10/22 TD 2680'

10/29 "

11/5 "

11/12 "

11/19 TD 2680' RUST

11/25 "

12/3 7" @ 2674'

Perf.

Acid 5000

Gas. 4,904,000

Rock Pr. 405#

Total Depth 2680'

COMPLETED

Map No. _____ Sec. 4 Twp. 26 R. 36W

Well No. 8 Masonic Home

Fin-Ker Company

FIRST REPORT Contractor

SE NE NW

SECTION PLAT

990 Ft. from N. Line

_____ Ft. from S. Line

330 Ft. from E. Line

_____ Ft. from W. Line

	o		.
.			

Kearny County

Location _____

Rig up _____

Drilling and Remarks:

16" @ 102,

drlg. 250

RECORD

Cased _____ in., _____ ft.

Sand _____

Gas _____

Oil _____

Total Depth _____

PRODUCTION

1st 24 hrs. Nat. _____

1st 24 hrs. after shot _____

Gas _____ Cu. Ft.

Dry Hole _____

Abandoned _____

Date

JUL 9 1947 19 S. J. LEWIS Scout

no

Misc. Small Maps _____

Cards _____ *no*

Tracing _____

France Map _____

Scarborough Map ~~X~~ _____

Pierce Map _____

Geological Dept. _____

Pierce Plat Book. _____

Map No. _____ Sec. 4 Twp. 26 R. 36W

Well No. 8 Masonic Home

Fin-Ker

Company

COMPLETE

Contractor

SE NE NW

E13044


SECTION PLAT

990 Ft. from N. Line

_____ Ft. from S. Line

330 Ft. from E. Line

_____ Ft. from W. Line

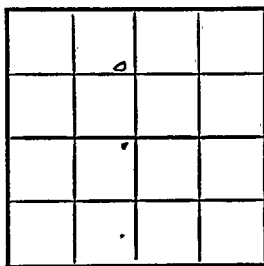

Kearny County

Location _____

Rig up _____

Drilling and Remarks:

7" @ 2674

*Perf
15000 gals*

4,904,000 gals

405th R/R

RECORD

Cased _____ in., _____ ft.

Sand _____

Gas _____

Oil _____

Total Depth 2680

PRODUCTION

1st 24 hrs. Nat. _____

1st 24 hrs. after shot _____

Gas _____ Cu. Ft.

Dry Hole _____

Abandoned _____

Date

DEC 3 1947 19

S. J. LEWIS

Scout

Worm

asc. Small Maps

Lords

Tracing

France Map

Scarborough Map

Pierce Map

Geological Dept.

Pierce Plat Book

Aug