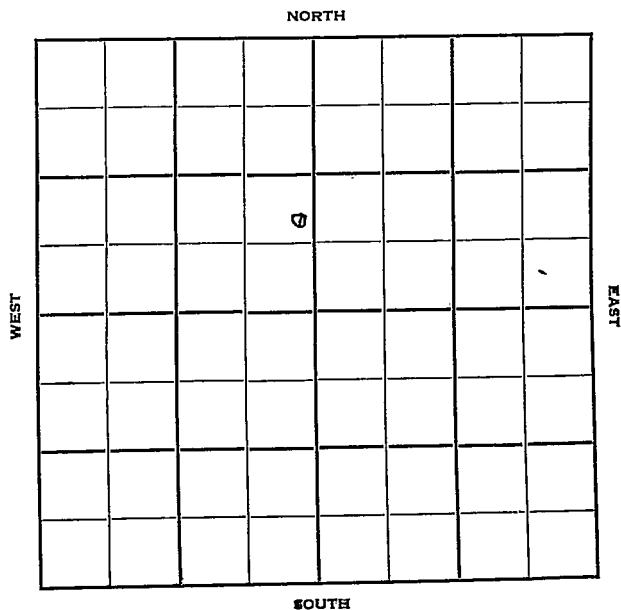


Section 4 Township 26 Range 33WWell No. #1 Brussell "B"Company Cities Service

Sec. 4 Twp. 26 R. 33W ✓

Well No. #1 Brussell "B" Farm

Cities Service

Company

Contractor

Hugoton Pool


Ft. from N. Line

885' Ft. from S. Line

100' Ft. from E. Line

Ft. from W. Line

C E L-SE NW

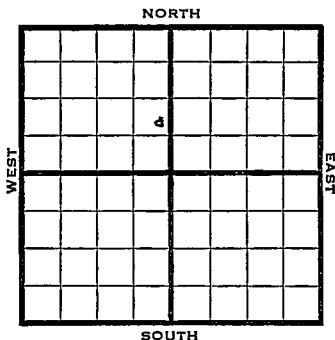

1950

Elev 2910

REPORT

4/19

8" @ 800'
Drlg. 2640'

5/17

TD 2729
8" @ 800
5" @ 2729
Hev 2530
Kr 2554
Win 2612
Ft Riley 2672
Perf 70/2624-38
" 30/2612-18
" 60/2587-98
" 110/2556-78

open flow

8-260,000 cu ft gas per day

Completed

COMPI FTED

Map No. _____ Sec. 4 Twp. 2 6 R. 33WWell No. 1 Brussell "B"

_____ Cities Service _____ Company

_____ Contractor

C E L S E N W


SECTION PLAT

_____ Ft. from N. Line

885 Ft. from S. Line100 Ft. from E. Line

_____ Ft. from W. Line

Finney County

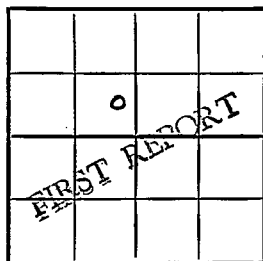

Location _____

Rig up _____

Drilling and Remarks: _____

8" @ 800

drlg. 2640

RECORD

Cased _____ in., _____ ft.

Sand _____

Gas _____

Oil _____

Total Depth _____

PRODUCTION

1st 24 hrs. Nat. _____

1st 24 hrs. after shot _____

Gas _____ Cu. Ft.

Dry Hole _____

Abandoned _____

Date

APR 19 1950 19J. E. TYRA

Scout

NOV 1949










APR 21 1950

Scout Cards	
Land Small Map	
Land Wall Map	
Tracings	
France Map	
Pierce Map	
Misc.	

Map No. 784-1 Sec. 26 Twp. 33WWell No. 1 Brussell "B"

Cities Service Company

Contractor

C E L S E N W E1. 2910

SECTION PLAT

Ft. from N. Line

885 Ft. from S. Line

100 Ft. from E. Line

Ft. from W. Line

Finney

Location

Rig up

Drilling and Remarks:

8" @ 800

5" @ 2729

Hv 2530

Rv 2554

Win 2612

Ft Riley 2672

Date (over)

MAY 17 1950 19

RECORD

Cased in. ft.

Sand

Gas

Oil

Total Depth 2729

PRODUCTION

1st 24 hrs. Nat.

1st 24 hrs. after shot

Gas Cu. Ft.

Dry Hole

Abandoned

J.E. Tyra Scout

perf 70/2624-38

30/2612-18 - 1st 2nd 3rd 4th

60/2586-98

110/2556-78

Open flow

8260,000

cu ft gas per day.

GAT-100

[illegible]

[Handwritten signature]

MAY 20

1968

Scout Cards 50
Land Small Map
Land Wall Map
Tracings
France Map
Pierce Map
Misc.

1950

1008 1
1009 2
1010 3
1427 420
14

216