


FORM 51 5M 10-41 PETROL

Section 20 Township 26 Range 5-W

Well No. 1 Schwartz

Company Dickey et al

NORTH Wildcat

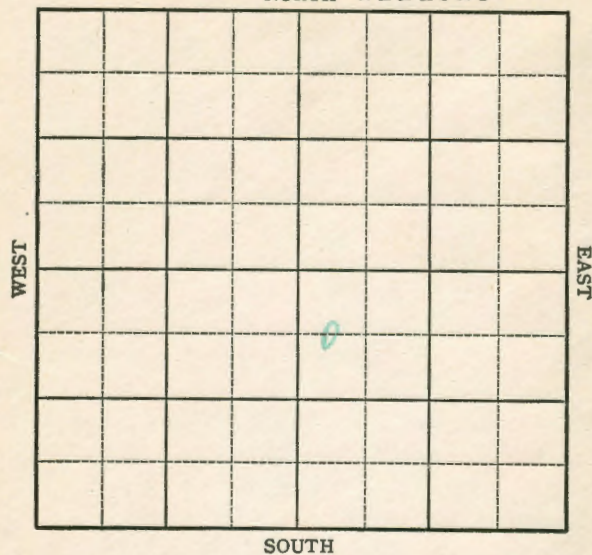

FORM 252 A
5M 10-41 PETROL

Sec. 20 Twp. 26 R. 5-W

Well No. #1 Schwartz Farm

Dickey et al _____ Company

(Wildcat)

660 Ft. from N. Line


Ft. from S. Line

Ft. from E. Line

330 Ft. from W. Line

Elev. 1460

NORTH

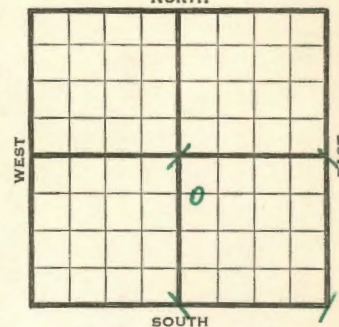

REPORT

1942

3/25	Location
------	----------

4/2	11
-----	----

4/8	10" - 103' WOC.
-----	-----------------

4/15	Dr1g. 2025'
------	-------------

4/22	Lans. 2890' ? Drlg. 3141'
------	---------------------------

4/29	Miss. 3640'	Drlg. 3725'
------	-------------	-------------

5/6	Kind. 3890'	Misener 4001'
-----	-------------	---------------

Viola 4035' Simp. Sand 4078'

Drlg. 4125'

5/13 Arb. 4170'

T.D. 4190'

No shows.

ABANDONED

KANSAS

Map No. 40 Sec. 20 Twp. 26 R. 5WWell No. 1 SchwartzDickey et al. Company**FIRST REPORT** Contractor

C WL NW SE


660 Ft. from N. Line

Ft. from S. Line

Ft. from E. Line

330 Ft. from W. Line

SECTION PLAT

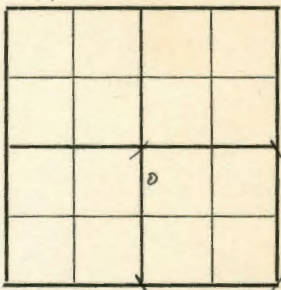

WILDCAT

Location XXX

Rig up

Drilling and Remarks:

RECORD

Cased in, ft.

Sand

Gas

Oil

Total Depth

PRODUCTION

1st 24 hrs. Nat.

1st 24 hrs. after shot

Gas Cu. Ft.

Dry Hole

Abandoned

Date

MAR 25 1942 19

S. J. LEWIS

Scout

Reno

KANSAS

Map No. 40 Sec. 20 Twp. 26 R. 5WWell No. 1 SchwartzDickey et al. Company**ABANDONED** Contractor

C WL NW SE


660 Ft. from N. Line

Ft. from S. Line

Ft. from E. Line

330 Ft. from W. Line

SECTION PLAT

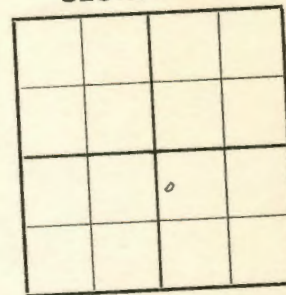

WILDCAT

Location

Rig up

Drilling and Remarks:

Oil 4170No show

RECORD

Cased in, ft.

Sand

Gas

Oil

Total Depth 4170

PRODUCTION

1st 24 hrs. Nat.

1st 24 hrs. after shot

Gas Cu. Ft.

Dry Hole

Abandoned

Date

MAY 13 1942

19

S. J. LEWIS

Scout

O. W. D. D

FORM 513 SUNRAY

County <u>Reno</u>		Elev. <u>1460</u>		Co.
Sec. <u>20</u>	Twp. <u>26</u>	Rge. <u>5W</u>		
Company <u>Ritchie & White & Ellis</u>				
Farm Name <u>Schwartz</u>		No. <u>1</u>		
TOPS	DEPTH	LOG	DATUM	Loc. in Sec.
Anh.				C W $\frac{1}{2}$ NW SE
Tr.				<u>OWDD</u>
Dg.				
Bl.	2900			Geol.
L.				Contr.
K.C.				
B.K.C.				
Ce.				
C.	3640			Pool
M.				
M.				
K.	4001			
Mz.	4035			
Me.	4078			
V.	4170			
S.				
A.				
R.				
Pe.				
G.				
T.D.	4190			
Date Comm. <u>CO 4176 DST 4166-76 open 1 $\frac{1}{2}$ hr.</u>				No.
<u>rec. 270' m & sw 1430/20" DST 4125-50</u>				
<u>open 1 hr. rec. 530' m & sw 1375/20"</u>				
<u>DST 4056-60 open 1 hr. rec. 2690' sw</u>				
<u>1476/20" DST 4011-30 open 1 hr.</u>				T.
<u>rec. 2900' sw 1420/20" DST 3643-60</u>				
<u>open 1 hr. rec. 305' sw 1180/20"</u>				R.
<u>D & A</u>				

FIRST REPORT
COMPLETE
MAY 8 57