


Section 5 Township 26 Range 37-W

Well No. #1 Otto Waechter "A"

Company Stanolind

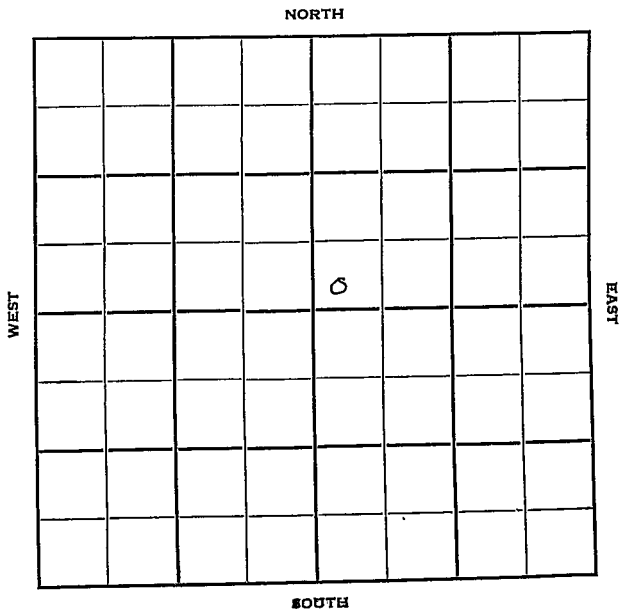

Kearny

Sec. 5 Twp. 26 R. 37W ✓

Well No. #1 Otto Waechter "A" Farm

Stanolind Company

Contractor

Hugoton Pool


Ft. from N. Line

200' Ft. from S. Line

Ft. from E. Line

250' Ft. from W. Line

SW NE

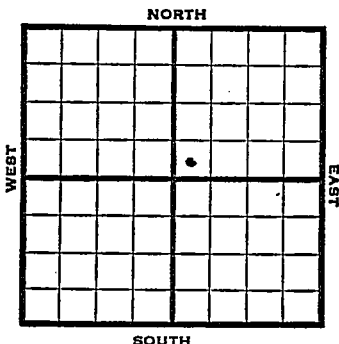

1950

Elev. 3087' REPORT

10/25

Location

12/27

Spud 11-26-50

Gas Well TD 2573'

10" @ 565

Krider 2363 Wins 2401

Ft. Riley 2477

7" @ 2530 TD 2573

72/2365-75 36/2380-86

36/2390-96

66/2404-15 54/2418-27 48/2403-38

180/2479-2509 18,000 total acid

Comp. 31,000,000 gas 425#

COMPLETED

County Kearny State Kansas

Sec. 5 (Blk. 26) (Sur. Rge.) 37W Map No. -

Operator Stanolind

Well No. 1 Farm Otto Waechter "A"

Elev. 3087 Location SW NE

200 Ft. From S Line NE

250 Ft. From W Line Quarter

Ist. Report

Completion DEC 27 1950

Remarks Hugoton Pool

Spudding Date 11-26-50

Drlg. Data Gas well TD 2573

10" C 565 Krider 2363 Win. 2401

Ft. Riley 2477 7" C 2530 TD 2573

72/ 2365-75 36/ 2380-86 36/ 2390-96

66/ 2404-15 54/ 2418-27 48/ 2430-38

180/ 2479-2509 18000 total acid

Comp. 31,000,000 gas 425#