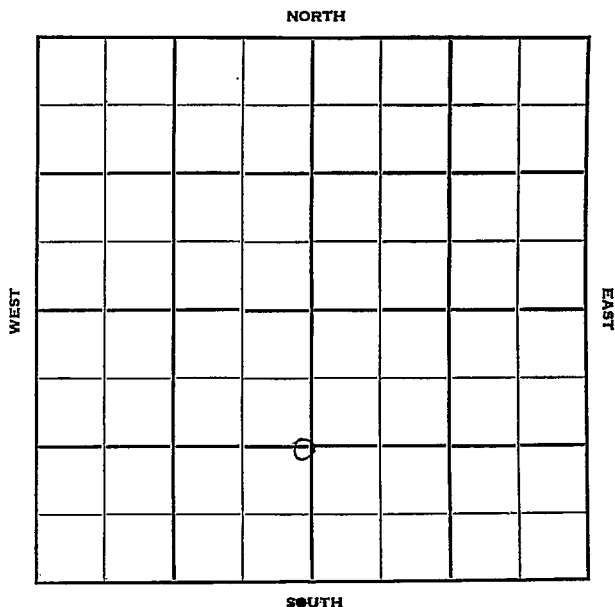


Section 5 Township 26 Range 33WWell No. #1 ThomasCompany Kansas-Nebraska

Finney

KANSAS

Sec. 5 Twp. 26 R. 33 W ✓

Well No. # 1 Thomas Farm

Kansas-Nebraska Company

Contractor

Hugoton Pool


 Ft. from N. Line

1320 Ft. from S. Line

 Ft. from E. Line

2540 Ft. from W. Line

C E L E $\frac{1}{2}$ SW

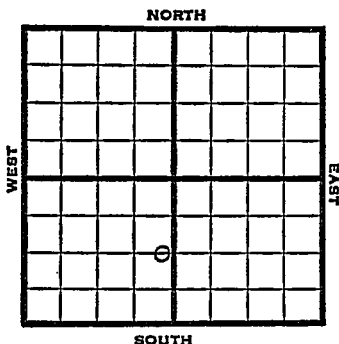

1951

Elv. 2923'

REPORT


5/16

Spud 5-5-51
10" @ 575

8/15

Spud 5-5-51
Gas Well TD 2730
10" @ 575
7" @ 2724
TD 2730 CO to 2720
120/2685-2705 Her. 2559 Krider 2579
Win 2621 Ft. Riley 2685
39,000 A Comp. 1,865,000 gas
404#

COMPLETED

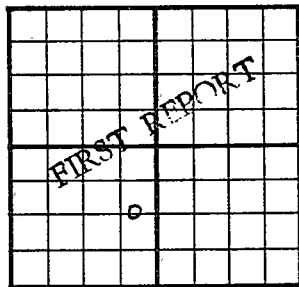County Finney State KansasSec. 5 (Blk. Twp.) 26 (Sur. Rge.) 33W Map No.Operator Kansas - NebraskaWell No. 1 Farm ThomasElev. Location C E L E $\frac{1}{2}$ SW1320 Ft. From S Line SW2540 Ft. From W Line Quarter1st. Report MAY 16 1951

Completion _____

Remarks _____


Spudding Date 5-5-51Drig. Data Hugoton Pool10" @ 575

J. E. TYRA

Scout Cards <i>MM</i>	MAY 18 1951
Land Small Map	
Land Wall Map	
Tracings	
France Map	
Pierce Map	
Misc.	

Orig. Date

County Finney State Kansas
 Sec. 5 (Blk.) 2 6 (Sur. Rge.) 3 3W Map No.
 Operator Kansas - Nebraska
 Well No. 1 Farm Thomas
 Elev. 2923 Location. C E L E $\frac{1}{2}$ SW

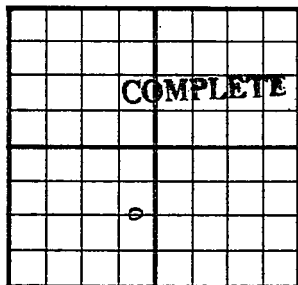

1320 Ft. From S Line SW
2540 Ft. From W Line Quarter

1st. Report

Completion AUG 15 1951

Remarks Hugot on Pool

Spudding Date 5-5-51

Drig. Data Gas well TD 2730

10" @ 575 7" @ 2724 TD 2730 CO to 272

90/ 2559-74 90/ 2579-94 90/ 2621-36

120/ 2685-2705 Her. 2559 Krider 2579

Win. 2621 Ft. Riley 2685 39000 A

Comp. 1,865,000 gas 404#

J. E. TYRA

15

1

AUG 27 1959

Scout Cards	
Land Small Map	
Land Wall Map	
Tracings	
France Map	
Pierce Map	
Misc.	

Drig. Date