

Reno

KANSAS

Sec. 2 Twp. 26 R. 6W

Well No. 1 T.J. Schrag Farm

Morris Mizel Company

Trans-Era Contractor


990 Ft. from N. Line

Ft. from S. Line

Ft. from E. Line

2310 Ft. from W. Line

SE/c of lot 3

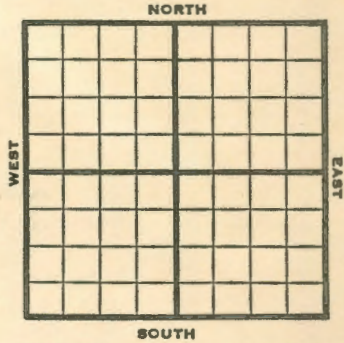

1953 **Elev. 1510'** REPORT

4/15 Spud 4-7-53
8" @ 215

Anhy 565' KC 2878'
Drlg 2880'

4/23 Br. L. 2879, Lans 2888, Miss 3578
DST 3582-3615 1 Hr. 30' gcm 1080'
gcsw 1150#
Drlg 3717'

4/29 Spud 4-7-53
D & A TD 4135' 8" @ 215
Anhy 565' KC 2878' Br lime 2877'
Lans 2888' Miss 3578'
DST 3582-3615 open 1 hr, rec 30' GCM
1080' GCSW 1150# Simp 4005'
Arb. 4106'
TD 4135'

ABANDONED

Reno

KANSAS

Section 2 Township 26 Range 6W

Well No. # 1 T. J. Schrag

Company Morris Mizel

