


Kearney

KANSAS

Section 6 Township 26 Range 36 W

Well No. # 22 Lee

Company Kansas-Nebraska

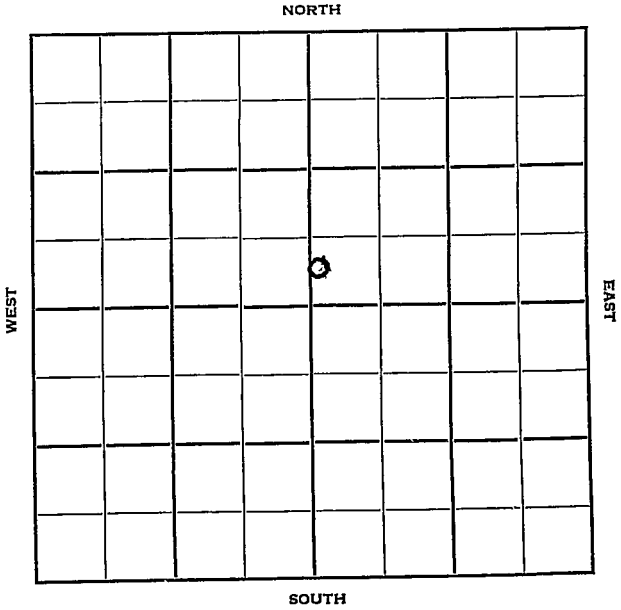

Sec. 6 Twp. 26 R. 36W

Well No. 22 Lee Farm

Kansas-Nebraska Company

Contractor


         Ft. from N. Line

450 Ft. from S. Line

         Ft. from E. Line

50 Ft. from W. Line

SW SW NE

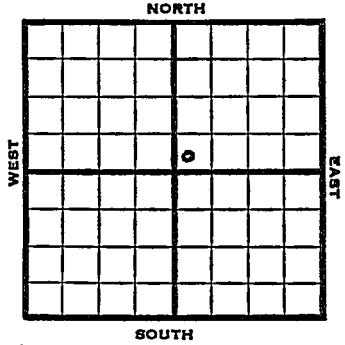

1953 Elev. 3051' REPORT

4/15 Spud 4-2-53  
8" @ 552  
TD 2665  
7" @ 2665

4/23 Testing

4/30 N.R.

5/7 NR

5/21 "

5/28 NR

6/3 NR

6/24 Spud 4-2-53  
Gas Well  
TD 2665  
8" @ 552  
TD 2665  
7" @ 2665

Her 2424, Kri 2444, Win 2486, Ft. Riley 2538

96/2424-40, 108/2444-62, 120/2486-2506,

156/2538-64, 168/2588-2616, 23000A

Comp. 3,396,000 gas, 390#

**COMPLETED**

County Kearny State Kansas

Sec. 6 (<sup>Blk.</sup>26 (<sup>Sur.</sup>36W) Map No.

Operator Kansas-Nebraska

Well No. 22 Farm Lee

Elev. \_\_\_\_\_ Location SW SW NE

|  |  |  |  |  |
|--|--|--|--|--|
|  |  |  |  |  |
|  |  |  |  |  |
450 Ft. From S Line NE

50 Ft. From W Line Quarter

1st. Report APR 15 1953

Completion \_\_\_\_\_

Remarks \_\_\_\_\_

Spudding Date 4-2-53

Drlg. Data \_\_\_\_\_

8" @ 552 TD 2665 7" @ 2665

APR 17 1963

|                |    |
|----------------|----|
| Scout Cards    | 25 |
| Land Small Map |    |
| Land wall map  | 3  |
| Tracings       |    |
| France Map     |    |
| Pierce Map     |    |
| Misc.          |    |

Orig. Data



20

JUN 30 1953

|                |       |
|----------------|-------|
| Scout Cards    | _____ |
| Land Small Map | _____ |
| Land Wall Map  | _____ |
| Tracings       | _____ |
| France Map     | _____ |
| Pierce Map     | _____ |
| Misc.          | _____ |

Dirig. Data