


KANSAS

Finney

Section 6 Township 26 Range 34WWell No. 1 CarltonCompany White Eagle

Hugoton

NORTH

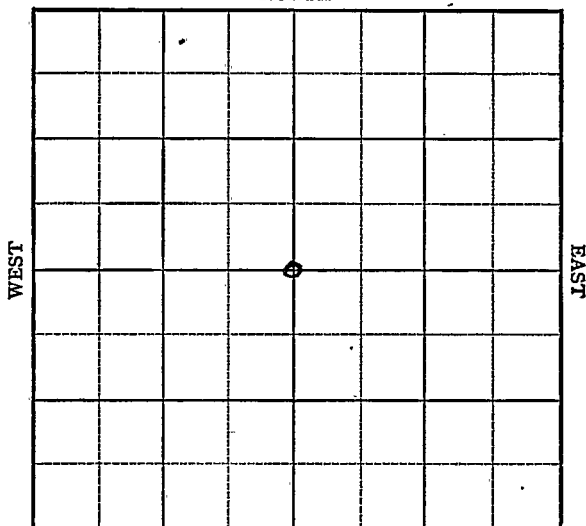

SOUTH

KANSAS Finney

Sec. 6 Twp. 26 R. 34W ✓

Well No. #1 Carlton Farm

White Eagle Company

Hugoton Pool (Burris, Cont.) NORTH


2640' Ft. from N. Line

Ft. from S. Line

2640' Ft. from E. Line

Ft. from W. Line

C Sec.

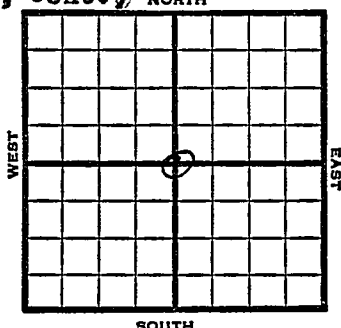

1949 Elev 3018' REPORT

5/18	Location
5/25	"
6/1	"
6/7	"
6/15	"
6/21	Drlg. 560'
6/28	TD 2530'
	7" @ 2514'
7/6	"
7/12	"
7/20	"
7/27	"
8/3	Drlg. 2570'
8/10	210" of 5" Perf liner @2718 TD
	Acid 13,000
8/17	"
8/24	TD 2718'
	7"@ 2514'
	210' of 5" Perf Liner @ 2718'
	13000 acid
	22,798,000 Gas
	420# R PR.
	Comp

COMPLETED

Kansas

Hugoton Pool

Map No. _____ Sec. 6 Twp. 26 R. 34WWell No. 1 CarltonWhite Eagle

Company

Burris

Contractor


C Sec.

FIRST REPORT
SECTION PLAT2640 Ft. from N. Line

_____ Ft. from S. Line

2640 Ft. from E. Line

_____ Ft. from W. Line

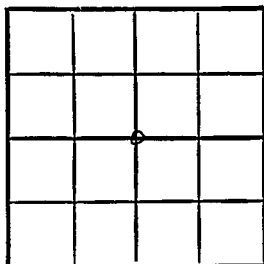Finney CountyLocation X

Rig up _____

Drilling and Remarks:

RECORD

Cased _____ in., _____ ft.

Sand _____

Gas _____

Oil _____

Total Depth _____

PRODUCTION

1st 24 hrs. Nat. _____

1st 24 hrs. after shot _____

Gas _____ Cu. Ft.

Dry Hole _____

Abandoned _____

Date

MAY 18 1949 19S. J. LEWIS

Scout

Map No. ✓ Sec. 6 Twp. 26 R. 34WWell No. 1 CarltonWhite Eagle

Company

COMPLETE

Contractor

C Sec.

21,301.8
SECTION PLAT2640


Ft. from N. Line

Ft. from S. Line

2640

Ft. from E. Line

Ft. from W. Line

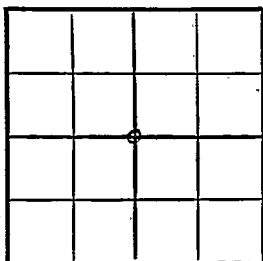

Finney County

Location

Rig up

Drilling and Remarks:

7" @ 2514210' by 5" Prof. Line@ 271813000 Acres22,798,000 Gall420 °R 1 1/2**RECORD**

Cased _____ in., _____ ft.

Sand _____

Gas _____

Oil _____

Total Depth 2718**PRODUCTION.**

1st 24 hrs. Nat. _____

1st 24 hrs. after shot _____

Gas _____ Cu. Ft.

Dry-Hole _____

Abandoned _____

Date

AUG 24 1949 19S. J. LEWIS Scout