

Map No. **KANSAS** Sec. 6 Twp. 26 R. S 9 W
 Well No. 2-Fields Farm
Silver Creek Company

NORTH

WEST

EAST

SOUTH

Location.....

Drilling Remarks

.....

.....

RECORD

Cased.....in.....ft.

Sand.....

Gas.....

Oil.....

Total Depth.....

Rig Up.....

Drilling Remarks

.....

.....

PRODUCTION

1st 24 hrs. Nat.....

1st 24 hrs. after shot.....

Gas.....cu. ft.....

Dry Hole.....

Abandoned.....

Map No. Sec. Twp. R.

Well No. Farm


..... Company

..... Ft. from N. Line

..... Ft. from S. Line

..... Ft. from E. Line

..... Ft. from W. Line

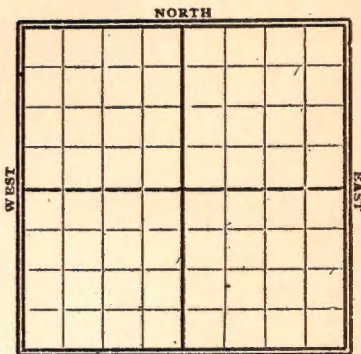

NW Cor of lot 4

Date

REPORT

Gypsy Records

Abd TD 3280'

MAP No. _____ SEC. 6 TWP. 16 S R. 70 NWELL No. 2 GildOliver Creek COMPANY __________
W. C. Wall CONTRACTOR _____

SECTION PLAT

_____ FT. FROM N. LINE

_____ FT. FROM S. LINE

_____ FT. FROM E. LINE

_____ FT. FROM W. LINE

LOCATION _____

RIG UP _____

DRILLING AND REMARKS:

N.W. corner of
lot 4

RECORD

CASED _____ IN. _____ FT.

SAND _____

GAS _____

OIL _____

TOTAL DEPTH 3780

PRODUCTION

1ST 24 HRS. NAT. _____

1ST 24 HRS. AFTER SHOT _____

GAS _____ CU. FT.

DRY HOLE ☒ABANDONED ☒

DATE _____

_____ 192 _____ SCOUT