


Section 7 Township 26 Range 38-W

Well No. #1 Martin

Company Stanolind

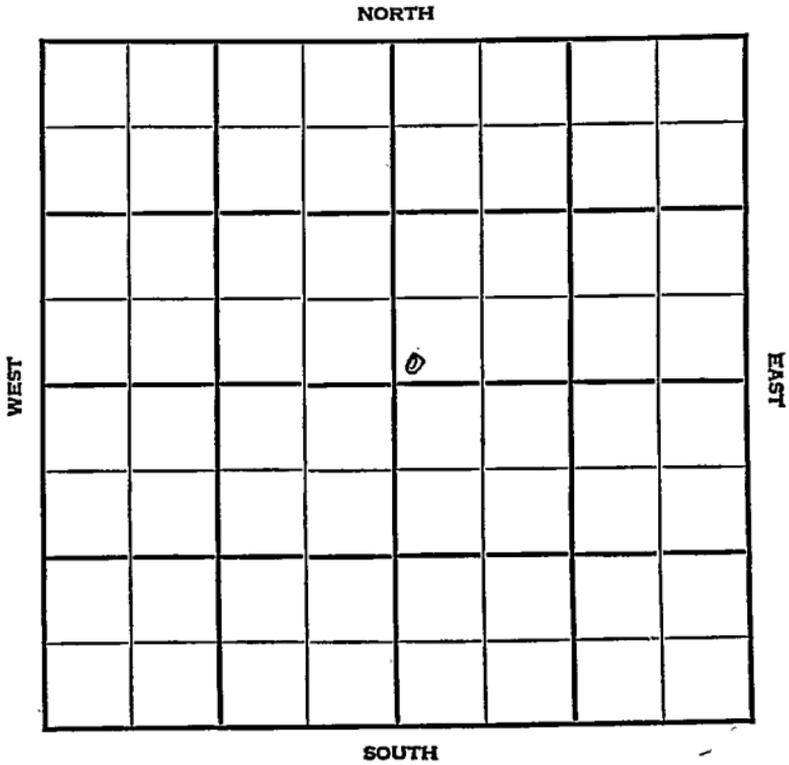

KANSAS

Sec. 7 Twp. 26 R. 38W ✓

Well No. #1 Martin Farm

Stanolind

Company

Hugoton Pool


_____ Ft. from N. Line

150' Ft. from S. Line

_____ Ft. from E. Line

150' Ft. from W. Line

SW NE

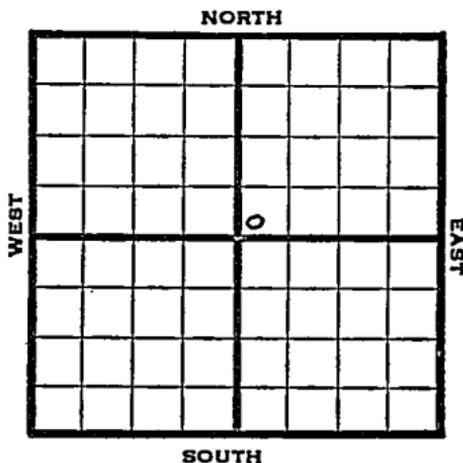

1948

Eli 3279'

REPORT

7/8 10" @ 593'
Drlg. 1655'

7/14 TD 2510'
7" @ 2476'

7/21 TD 2690'
234' of 5" Perf Liner @ 2690'
17000 acid

7/28 TD 2690'
7" @ 2476'
234' of 5" Perf Liner @ 2690'
17000 acid
16,732,000 gas
415# R Pr.
Comp

COMPLETED

Map No. _____ Sec. 7 Twp. 26 R. 38W

Well No. 1 Martin

Stanolind Company

FIRST REPORT Contractor

SW NE

SECTION PLAT

		o	

_____ Ft. from N. Line

150 Ft. from S. Line

_____ Ft. from E. Line

150 Ft. from W. Line

Kearny County

Location _____

Rig up _____

Drilling and Remarks:

10" @ 593

drlg. 1655

RECORD

Cased _____ in., _____ ft.

Sand _____

Gas _____

Oil _____

Total Depth _____

PRODUCTION

1st 24 hrs. Nat. _____

1st 24 hrs. after shot _____

Gas _____ Cu. Ft.

Dry Hole _____

Abandoned _____

Date

JUL 8 1948 1948

S. J. LEWIS Scout

Kearny County Kansas State

Map No. _____ Sec. 7 Twp. 26 R. 38W

Well No. 1 Martin

Stanolind Company

COMPLETE

Contractor

SW NE

E13279
SECTION PLAT

_____ Ft. from N. Line

150 Ft. from S. Line

_____ Ft. from E. Line

150 Ft. from W. Line

Hugoton Pool

Remarks:

XJ2690

7' @ 2476

234' of 5" Profined @ 2690

17000 and

16,732,500 Gal

415 R/L

Date

JUL 28 1948

Scout

S. J. LEWIS