


Section 7 Township 26 Range 36W

Well No. 16 Lee

Company Kansas & Nebraska

NORTH

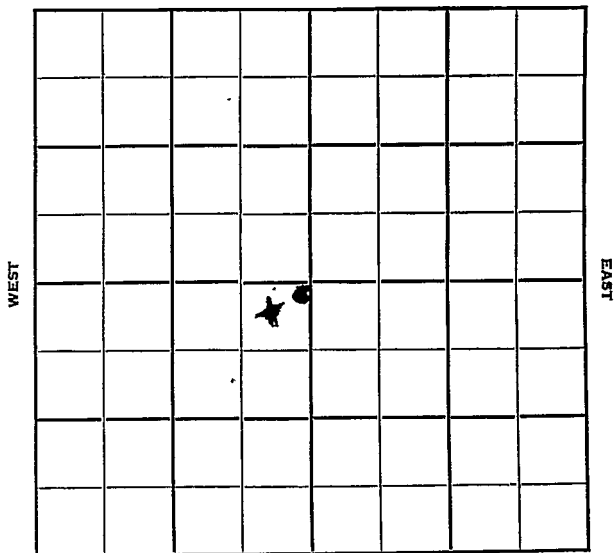

SOUTH

Kearny

KANSAS 36W

Sec. 7 Twp. 26 R. 36W

Well No. #16 Lee Farm

Kansas & Nebraska Company

Contractor

Hugoton Pool


100' Ft. from N. Line

Ft. from S. Line

75' Ft. from E. Line

Ft. from W. Line

NE SW

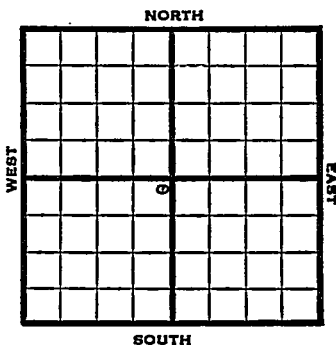

1951	Elev. - REPORT
7/19	Spud, 5-31-51 10" @ 565' RTD 2660 7" @ 2652
9/26	Spud 5-31-51 Gas well TD 2660' 10" @ 565 7" @ 2652' TD 2660' Her. 2418' Win. 2480' Ft. Riley 2532' C/O to 2647' 204/2418-52 100/2480-2500 144/2500-58 180/2580-2610 50,500 A Comp. 2,978,000 gas
<p>COMPLETED</p>	

