

Sec. 8 Twp. 26 R. 35-W

Well No. #1 U S A White "C" Farm

Magnolia Company
Hugoton


 Ft. from N. Line

330 Ft. from S. Line

330 Ft. from E. Line

 Ft. from W. Line

SE NW

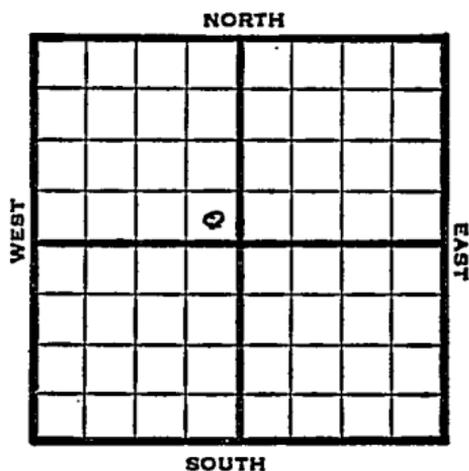

1948	Eli 3026'	REPORT
10/6	Location	
10/13	RUR	
10/19	10" @ 841'	
	Drlg. 2207'	
10/26	TD 2783'	
	7" @ 2782'	
11/3	120 shots 2711-38	7000 acid
	120 shots 2668-92	7000 acid
	96 shots 3602-28	7000 acid
	216 shots 2544-86	7000 acid
11/10	"	
11/16	"	
11/23	TD 2783'	
	7" @ 2782'	
	Perf 28000 acid	
	13,200,000 Gas	
	403# R Pr.	
	Comp	
	COMPLETED	

Map No. _____ Sec. 8 Twp. 26 R. 35W

Well No. 1 U S A White "C"

Magnolia Company

FIRST REPORT

Contractor

SE NW

SECTION PLAT

_____ Ft. from N. Line

330 _____ Ft. from S. Line

330 _____ Ft. from E. Line

_____ Ft. from W. Line

Kearny County

Location X

Rig up _____

Drilling and Remarks:

RECORD

Cased _____ in., _____ ft.

Sand _____

Gas _____

Oil _____

Total Depth _____

PRODUCTION

1st 24 hrs. Nat. _____

1st 24 hrs. after shot _____

Gas _____ Cu. Ft.

Dry Hole _____

Abandoned _____

Date

OCT 6 1948

19

S. J. LEWIS

Scout

Map No. _____ Sec. 8 Twp. 26 R. 35W

Well No. 1 U S A - White "C"

Magnolia Company

COMPLETE

Contractor

SE NW

E 13026

SECTION PLAT

		<i>0</i>	

_____ Ft. from N. Line

330 Ft. from S. Line

330 Ft. from E. Line

_____ Ft. from W. Line

Kearny County

Location _____

Rig up _____

Drilling and Remarks:

7" @ 2782
Perf
28050 acid

13,200,000 Gal

403 # R Pz

RECORD

Cased _____ in., _____ ft.

Sand _____

Gas _____

Oil _____

Total Depth 2782

PRODUCTION

1st 24 hrs. Nat. _____

1st 24 hrs. after shot _____

Gas _____ Cu. ft.

Dry Hole _____

Abandoned _____

Date

10/1 - 3 1940

S. J. LEWIS Scout