


Section 8 Township 26 Range 36W

Well No. #23 Lee

Company Kansas-Nebraska

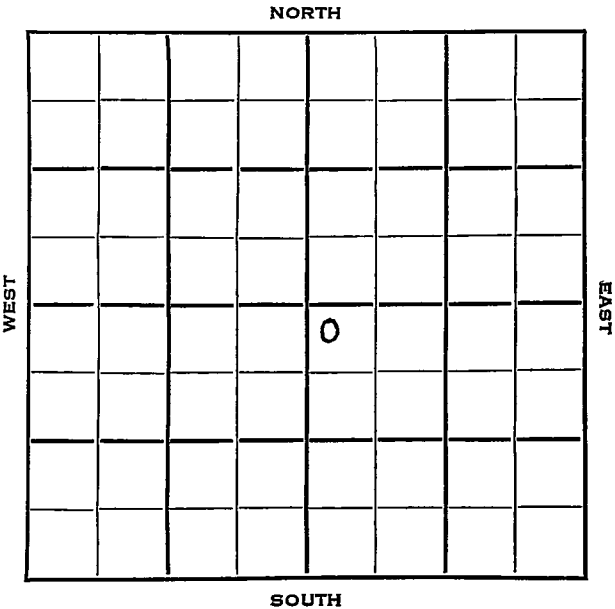

Kearny **KANSAS**
26

Sec. 8 Twp. 26 R. 36W

Well No. #23 Lee Farm

Kansas-Nebraska Company

Contractor

Hugoton Pool


200 Ft. from N. Line

Ft. from S. Line

Ft. from E. Line

100 Ft. from W. Line

NW SE

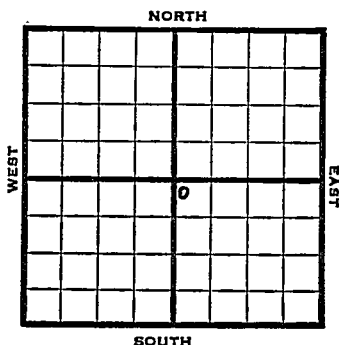

1953

Elev. 3041' REPORT

4/29

Location

5/7

"

5/21

"

5/28

"

6/3

"

6/10

"

6/24

"

7/1

"

8/19

10" @ 555'

RTD 2670'

7" @ 2661'

8/26

NR

9/9

78/2446-59 102/2463-80 144/2500-24
144/2564-88 168/2608-36 17,000 A
8000 A

9/16

Her 2446, Kr 2463, Win 2500, Up Ft.
2564, Low Ft. 2608'

9/23

N.R.

10/14

Spud 7-25-53

Gas Well

TD 2670'

10" @ 555'

OVER

1953

Information brought forward.

10/14 TD 2670

7 @ 2661

78/ 2446-59 102/ 2463-80 144/ 2500-

24 144/ 2564-88 168/ 2608-36

17000 A 8000 A Her. 2446, Kri 2463,

Win 2500, Ft. Riley 2564

Comp 14,784,000 gas

COMPLETED

County Kearny State KansasSec. 8 (Blk.) 26 (Sur.) 36W Map No.Operator Kansas-NebraskaWell No. 23 Farm LeeElev. Location NW SE

200 Ft. From N Line SE700 Ft. From W Line Quarter1st. Report APR 29 1953

Completion

Remarks

Spudding Date

Drig. Data Hugoton Pool

Location


J. G. McGEHEE

MAY 1 1953

Scout Cards	_____
Land Small Map	_____
Land Wall Map	_____
Tracings	_____
France Map	_____
Pierce Map	_____
Misc.	_____

Orig. Date

County Kearny State Kansas
 Sec. 8 (Blk. 26 (Sur. 36W Map No.
 (Twp.) (Rge.)
 Operator Kansas-Nebraska
 Well No. 23 Farm Lee
 Elev. 3041 Location NW SE

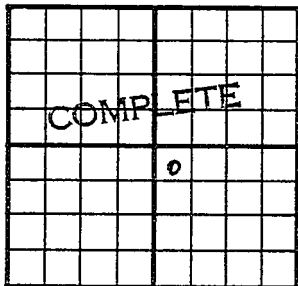

200Ft. From N Line SE
100Ft. From W Line Quarter
 1st. Report
 Completion OCT 14 1953
 Remarks Hugoton Pool
 Spudding Date 7-25-53

Drilg. Data Gas well TD 2670
10" @ 555 TD 2670 7" @ 2661
78/ 2446-59 102/ 2463-80 144/ 2500-24
144/ 2564-88 168/ 2608-36 17000 A
8000 A Her. 2446 Kri. 2463 Win. 2500
Ft. Riley 2564 Comp. 14,784,000 gas

